

DX 78-1


Morton

KANSAS

Section 7 Township 33 Range 43 W

Well No. #1 Well "B"

Company Cities Service Gas Development

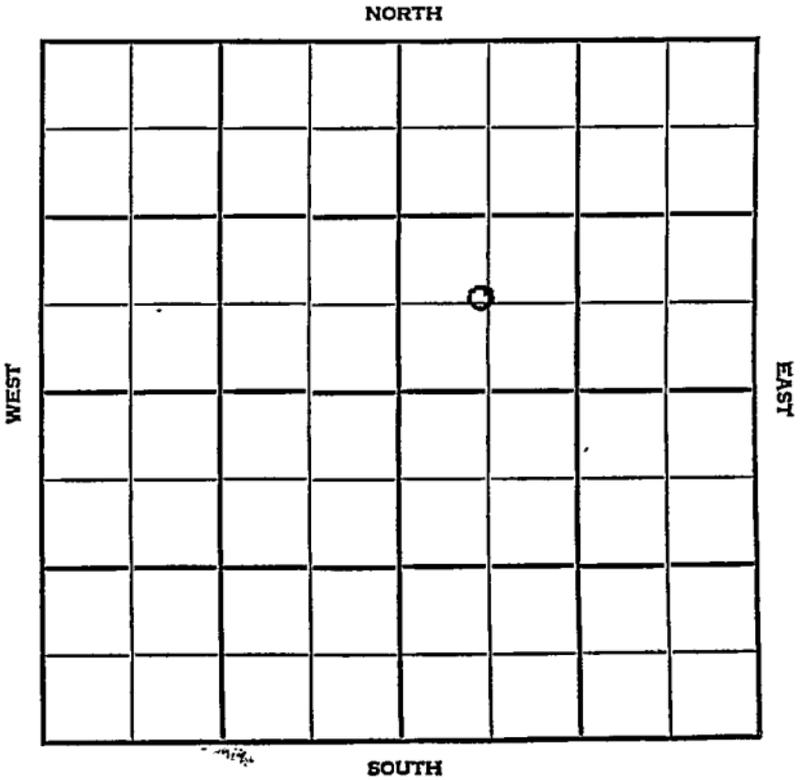

Morton

KANSAS

SEC. 7	TWP. 33	R. 43W
-----------	------------	-----------

WELL NO.

#1 Neil "B"

FARM

COMPANY

Cities Service Gas Development

CONTRACTOR

Holm Brlg.

Greenwood  
1998


\_\_\_\_\_ Ft. from N. Line

\_\_\_\_\_ Ft. from S. Line

1990 \_\_\_\_\_ Ft. from E. Line

\_\_\_\_\_ Ft. from W. Line

C SW NE

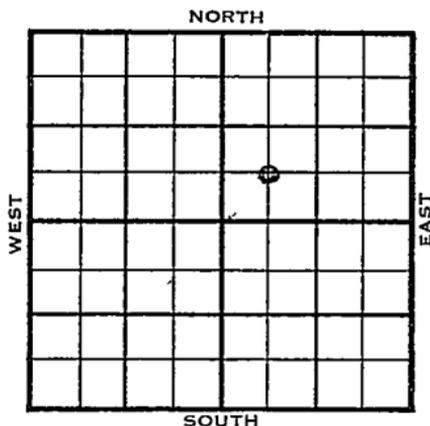

1955	ELEVATION 3666'	REPORT
------	--------------------	--------

8/3	Comm. 7-30-55 8" @600/400 WOC	<b>FIRST REPORT</b>
9-7	5 1/2" @ 3200 CO to 3158, 40/ 3086-94, 80/ 3054-70 320 mcfg, 3000 A 4,740 mcfg SP 3045, 30/ 3016-22, 50/ 3002-12 30/ 2992-98, 50/ 2074-84, 40/ 2956-64 5000 A 5,150 mcfg, 2000 A CO to 3158, 2000 A, Comp. 8,150 mcfgpd. Tops Log Neva 2552 Tp. 2897 L. 3182 Jacques 3050 T.D. 3205'	<b>COMPLETED</b>

~~XXXXXXXXXX~~

County Morton Elev. 3666  
 Sec. 7 Twp. 33 Rge. 43W  
 Company Cities Service Gas Development  
 Farm Name Neil "B" No. 1

TOPS	DEPTH	LOG	DATUM	Loc. in Sec.
Anh. <u>1/0.12</u>		<u>2552</u>		C SW NE
TP.		<u>2297</u>		
H.				1990' NL
Tr.				1990' EL
Dg.				
BL.				
L.		<u>3182</u>		Geol.
K.C. <u>Traces</u>		<u>2850</u>		Contr.
B.K.C.				
Ce.				Holm Drlg.
C.				
M.				Pool
M.				Greenwood
K.				
Mz.				
Me.				
V.				
S.				
S.				
A.				
R.				
PE.				
G.				
TP.	<u>320.5</u>			

Date Comm. 7-30-55 SEP 7 1955

8" @ 600/400 5 1/2" @ 3200 CO to 3158  
 40/ 3086-91 80/ 3054-70 320 mcfg  
 3000 A 4,740 mcfg SP 3045 30/ 3016-22  
 50/ 3002-12 30/ 2992-98 50/ 2074-84  
 40/ 2956-61 5000 A 5,150 mcfg 2000 A  
 CO to 3158 2000 A Comp. 8,150 mcfgpd

County Morton Elev. \_\_\_\_\_  
 Sec. 7 Twp. 33 Rgs. 43W  
 Company Cities Service Gas Development  
 FarmName Neil "B" No. 1

TOPS	DEPTH	LOG	DATUM	Loc. in Sec.
Anh.				C SW NE
Ip.				1990' NL
H.				1990' EL
Tr.				
Dg.				
Bl.				
L.				Geol.
K.C.				Contr.
B.K.C.				Holm Drlg.
Ce.				
C.				Pool
M.				Greenwood
M.				
K.				
Mz.				
Me.				
V.				
S.				
S.				
A.				
R.				
PE.				
G.				
T.D.				

FIRST REPORT  
 0  
 AUG 3 '55

Date Comm. 7-30-55  
8" @ 600/400 WOC

*[Handwritten signature]*

Co.

Lsc.

No.

Sec.

T.

R.