


Section 7 Township 33 Range 40 W

Well No. # 1-7 Low

Company Panhandle Eastern

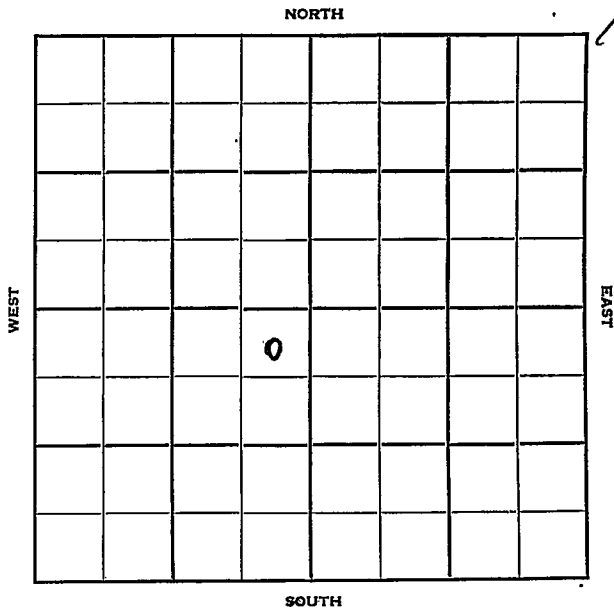

Sec. 7 Twp. 33 R. 40 W

Well No. # 1-7 Low Farm \_\_\_\_\_

Panhandle Eastern Company \_\_\_\_\_

Contractor \_\_\_\_\_

**Hugoton Pool**


330 Ft. from N. Line

\_\_\_\_\_ Ft. from S. Line

330 Ft. from E. Line

\_\_\_\_\_ Ft. from W. Line

NE NE SW

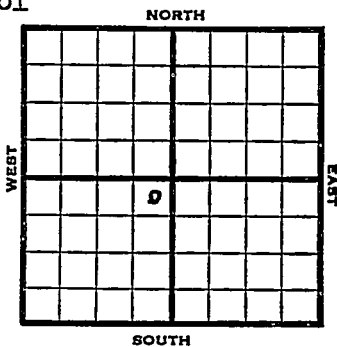

1953

Elev. 3388' REPORT

6/24

Spud 6-16-53  
10" @ 641  
Drlg. 1900'

7/1

RTD 2350' 7" @ 2338  
DD 2486 PB 2441'

7/8

115' of 5" liner

7/22

N.R.

8/19

11,000 A

9/2

6000 A

9/9

Spud 6-16-53  
Gas Well  
TD 2486'  
10" @ 641'  
Kri. 2342, Win 2411, Ft. Riley 2472,  
TD 2486'  
PB 2441  
10000 A PB 2398 27000 A  
Comp. 4,048,000 gas.

**COMPLETED**



County Morton State Kansas

Sec. 7 (Blk. 33) (Sur. Rge.) 40W Map No.

Operator Parhandle Eastern

Well No. 1 Farm Low

Elev. 3388 Location NE NE SW

COMPLETE					

330 Ft. From N Line SW

330 Ft. From E Line Quarter

Ist. Report

SEP 9 1953

Completion

Remarks Hugoton Pool

Spudding Date 6-16-53

Drlg. Data Gas well TD 2486

10" @ 641 Kri. 2342 Win. 2411

Ft. Riley 2472 TD 2486 PB 2441

10000 A PB 2398 27000 A

Comp. 4,048,000 gas