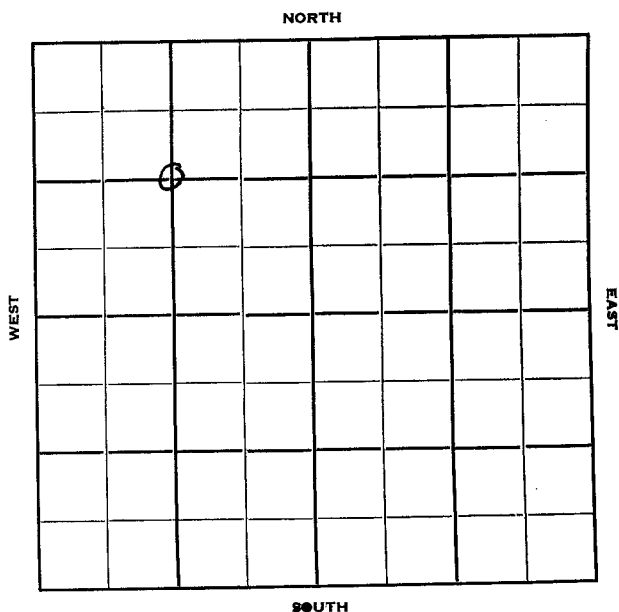


Section 7 Township 33 Range 33-WWell No. #1 HarrisonCompany Cabot Carbon

Seward

7

33

33-W

Sec. _____ Twp. _____ R. _____

Well No. #1 Harrison Farm

Cabot Carbon Company

Hugoton Contractor


1320 Ft. from N. Line

_____ Ft. from S. Line


_____ Ft. from E. Line

1320 Ft. from W. Line

C NW/4

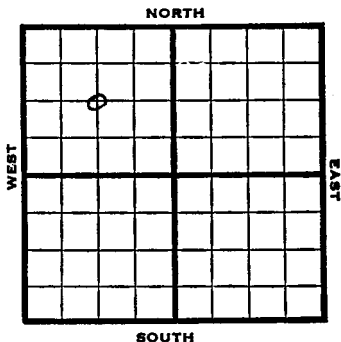

1951	Elev. 2845' REPORT
1/10	Spud 1-4-51 10" @ 417 Drlg 2540'
3/27	Spd 1-4-51 Gas Well TD 2651 10" @ 417' 7" @ 2533 TD 2651 Her 2555' Kider 2580 Win. 2638' PB 2628 21,000 A Comp. 21,600,000 gas 426#
	COMPLETE

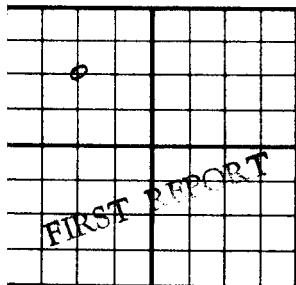County **Seward** State **Kansas**Sec. **7** (Blk. Twp.) **33** (Sur. Rge.) **33W** Map No.Operator **Cabot Carbon**Well No. **1** Farm **Harrison**Elev. Location **C NW/4**1320 Ft. From **N** Line **NW**1320 Ft. From **W** Line **Quarter**1st. Report **JAN 10 1951**

Completion

Remarks

Spudding Date **1-4-51**Drlg. Data **Hugoton Pool****10" @ 417 drlg. 2540**


J. E. TYRA

County Seward State Kansas
 Sec. 7 (Blk. 33 (Sur. 33W Map No.
 (Twp.) (Rge.)

Operator Cabot Carbon

Well No. 1 Farm Harrison

Elev. 2845 Location C NW/4

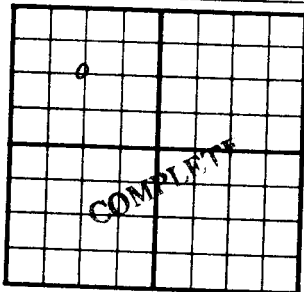

1320 Ft. From N Line NW

1320 Ft. From W Line Quarter

1st. Report

Completion MAR 66

Remarks Hugoton Pool

Spudding Date 1-4-51

Drig. Data Gas well TD 2651

10" @ 417 7" @ 2533 TD 2651

Her. 2555 Krider 2580 Win. 2638

PB 2628 21000 A Comp. 21,600,000 gas
426#

J. E. TYRA