

KANSAS


Stevens

Section 7 Township 33 Range 38W

Well No. 1 Shafer

Company Panhandle Eastern

Hugoton

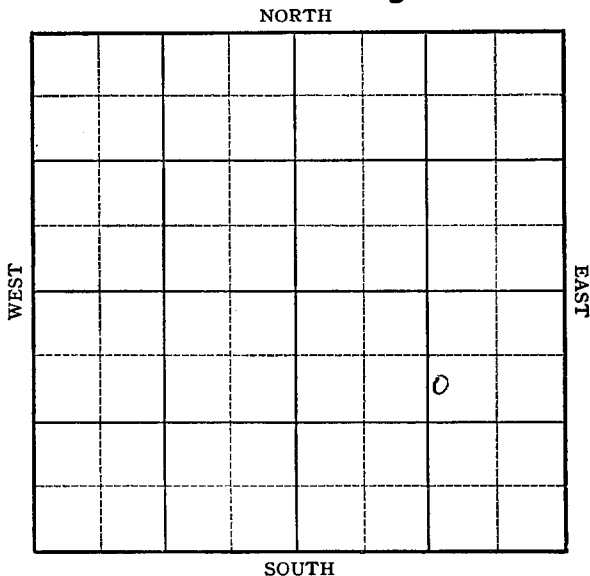

KANSAS

Stevens

Sec. 7 Twp. 33 R. 38W ✓

Well No. #1 Shafer Farm

Panhandle Eastern Company


Hugoton Pool

 Ft. from N. Line

1760' Ft. from S. Line

1292' Ft. from E. Line

 Ft. from W. Line

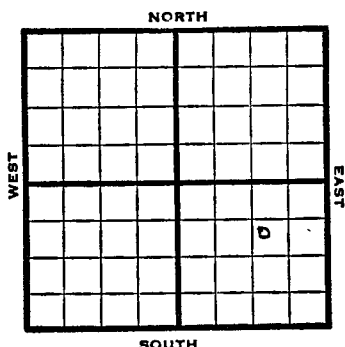

C W L NE SE

1949 Elev 3187' REPORT

3/23	Location
3/30	"
4/6	RUR
4/12	10" @ 470' Drlg. 1950'
4/20	TD 2454' 7" @ 2443'
4/27	Drlg. 2690'
5/4	"
5/12	"
5/18	"
5/25	"
6/1	"
6/7	"
6/15	"
6/21	"
6/28	"
7/6	"
7/13	TD 2690' 7"@ 2443' 11,720,000 Gas 352# R Pr. Comp

COMPLETED

Kansas

Map No. 1 Sec. 7 Twp. 33 R. 38WWell No. 1 ShaferPanhandle Eastern Company**COMPLETE**

Contractor

C W L NE SE

E 113187
SECTION PLAT

			0

 Ft. from N. Line1760 Ft. from S. Line1292 Ft. from E. Line Ft. from W. LineStevens CountyLocation Rig up

Drilling and Remarks:

*21' 02443**11, 720, 000 ft**302 # R/A***RECORD**Cased in., ft.Sand Gas Oil Total Depth 2690**PRODUCTION**1st 24 hrs. Nat. 1st 24 hrs. after shot Gas Cu. Ft.Dry Hole Abandoned

Date

JUL 13 1949 19S. J. LEWIS Scout

Map No. _____ Sec. 7 Twp. 33 R. 38W

Well No. 1 Shafer

Panhandle Eastern

Company

FIRST REPORT

Contractor

C W L N E S E

SECTION PLAT

			.
			o

_____ Ft. from N. Line

1760 Ft. from S. Line

1292 Ft. from E. Line

_____ Ft. from W. Line

Stevens County

Location X

Rig up _____

Drilling and Remarks:

RECORD

Cased _____ in., _____ ft.

Sand _____

Gas _____

Oil _____

Total Depth _____

PRODUCTION

1st 24 hrs. Nat. _____

1st 24 hrs. after shot _____

Gas _____ Cu. Ft.

Dry Hole _____

Abandoned _____

Date

MAR 23 1949

19

S. J. LEWIS

Scout