


Section 32 Township 33 Range 8-W

Well No. #1, Rex Peacock

Company Amerada

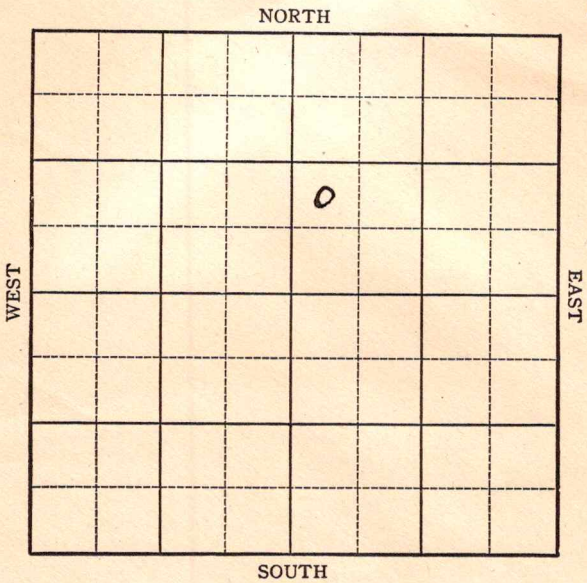

Sec. 32 Twp. 33-S R. 8-W

Well No. #1 Rex Peacock Farm


Amerada Company

           Ft. from N. Line

990' Ft. from S. Line

           Ft. from E. Line

330' Ft. from W. Line  
NW SW NE

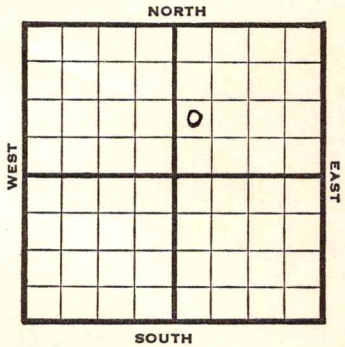

1946 **1334** REPORT

9/5 Location

9/10 RUR

9/18 8" @ 1335' WOC

9/24 Ft. Riley 1700 B Flo  
1840 Drlg 3300'

10/1 Stl 3497  
Lay 3744  
KC 4020'  
Drlg 4460'

5020  
1334  

---

3686

10/8 Miss 4566'  
Drlg 4767'

10/15 B Miss 4854  
Viola 4925  
Simp 5020  
Drlg 5142'

10/23 Viola 4952'  
Simps 5020'  
TD 5149'

**ABANDONED**

Kansas Pool Name Wildcat

Map No. 33 Sec. 32 Twp. 33 R. 8W

Well No. 1 Rex Peacock

Amerada Company

**FIRST REPORT**

Contractor

NW SW NE

**SECTION PLAT**

           Ft. from N. Line

990 Ft. from S. Line

           Ft. from E. Line

330 Ft. from W. Line

		o	

Harper County

Location X

Rig up           

Drilling and Remarks:           

**RECORD**

Cased            in.,            ft.

Sand           

Gas           

Oil           

Total Depth           

**PRODUCTION**

1st 24 hrs. Nat.           

1st 24 hrs. after shot           

Gas            Cu. Ft.

Dry Hole           

Abandoned           

Date

SEP 5 1946 19

S. J. LEWIS

Scout

