
Harper KANSAS

SECTION 2 TOWNSHIP 33 RANGE 8W

WELL NO. #1 McKaig

COMPANY Rupp-Ferguson

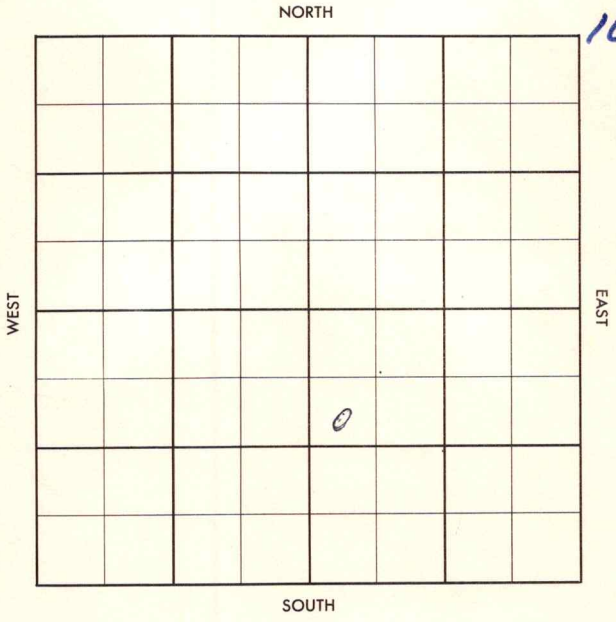

Harper KANSAS

SEC.	TWP.	R.
2	33	8W

WELL NO.

#1 McKaig FARM

COMPANY

Rupp-Ferguson

CONTRACTOR

Co Tools


Wildcat

_____ FT. FROM N. LINE

_____ FT. FROM S. LINE

_____ FT. FROM E. LINE

_____ FT. FROM W. LINE

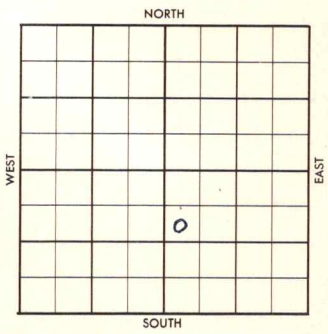

SW NW SE Sohio FO & DHM

ELEVATION	REPORT
1956	
9-12	Comm 9-6-56 8" @ 233/200 Drlg 2185

FORM 504-5 SUNRAY

FORM 513 SUNRAY

County Harper Elev.

Sec. 2 Twp. 33 Rge. 8W

Company Rupp-Ferguson

Farm Name McKaig No. 1

TOPS	DEPTH	LOG	DATUM
Anh.			
Tp.			
H.			
Tr.			
Dg.			
Bl.			
L.			
K.C.			
B.K.C.			
Ce.			
C.			
M.			
M.			
K.			
Mz.			
Mc.			
V.			
S.			
S.			
A			
R.			
P€.			
G.			
T.D.			

Loc. in Sec. SW NW SE

Geol.

Contr. Co. tools

Pool Wildcat

SEP 12 56

FIRST REPORT

Date Comm. 9-6-56 Sohio FO & DHM

8" @ 233/200 drlg. 2185

Co. Lse. No. Sec. T. R.

FORM 513 SUNRAY

County Harper Elev. 1392 RB

Sec. 2 Twp. 33 Rge. 8W 1389DF

Company Rupp-Ferguson

Farm Name McKaig No. 1

TOPS	DEPTH	LOG	DATUM
Anh.			
Tp.			
H.	3393		
Tr.			
Dg.	3450		
Bl. Stall	3683		
L.			
K.C.	3953		
B.K.C. Marm	4161		
Ce.			
C.			
M.	4486		
M.			
K.	4782		
Mz.	4863		
Mo.			
V.	4864		
S. Dolo	4896		
S. Sd	4908		
A			
R.			
Pe.			
G.			
T.D.	4935		

Loc. in Sec. SW NW SE

Geol.

Contr. Co. tools

Pool Wildcat

ABANDONED

SEP 26 '56

Date Comm. 9-6-56 Sohio FO & DHM

8" @ 233/200 drlg. 2185 SEP 19 '56

ID 4438 SEP 26 '56 DST 4488-4500

1hr 25' GCM FP 0-0 BHP

~~1545~~ - 1110/20" DST 4522-72

1hr 735' GCSW (SSO) BHP

1580/20"

O&A.

Co. Lse. No. Sec. T. R.