

Harper

KANSAS

SECTION 12 TOWNSHIP 33 RANGE 8 W

WELL NO. #1 Alferd Miller

COMPANY Skelly Oil

NORTH

12

WEST

EAST

0							

SOUTH

Harper

KANSAS


SEC.	TWP.	R.
12	33	8W

WELL NO. #1 Alfred Miller FARM

COMPANY Skelly Oil

CONTRACTOR Hulme Wrlg Miller

_____ Ft. from N. Line
 _____ Ft. from S. Line
 _____ Ft. from E. Line
 _____ Ft. from W. Line

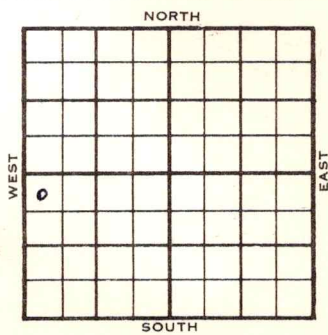

NW NW SW

1955	ELEVATION 1371	REPORT
------	-------------------	--------

11/16 Comm 11/13/55
 8" @ 315/260
 WOC

12-7 DST 4493-4520 op 1 hr. rec. 20' mud
 35#
 DST 4898-4926 op 1/2 hr. rec. 12' mud,
 55#
 DST 4983-5004 op 1 hr. rec. 70' wm
 3255' sw, 2000#
 D & A

<u>Tops</u>	<u>Depth</u>	<u>Log</u>
KC	3958	3958
BKC		4169
Marm	4240	4240
M.	4498	4500
K.	4813	4814
Sd	4904	4902
V.	4909	4910
Sd	4984	4985

TD 5004'

ABANDONED

County Harper Elev. 1371
 Sec. 12 Twp. 33 Rge. 8W
 Company Skelly Oil
 Farm Name Alfred Miller No. 1

Co.

TOPS	DEPTH	LOG	DATUM
Anh.			
Tp.			
H.			
Tr.			
Dg.			
Bl.			
L.			
K.C.	<u>3958</u>	<u>3958</u>	<u>3587</u>
B.K.C.		<u>4169</u>	<u>3798</u>
Ce. <u>Marm</u>		<u>4240</u>	<u>2869</u>
C.			
M.	<u>4498</u>	<u>4500</u>	<u>3129</u>
M.			
K.	<u>4813</u>	<u>4814</u>	<u>3443</u>
Mz. <u>sd.</u>	<u>4904</u>	<u>4902</u>	<u>3531</u>
Me.			
V.	<u>4909</u>	<u>4910</u>	<u>3539</u>
S. <u>sd.</u>	<u>4984</u>	<u>4985</u>	<u>3614</u>
S.			
A.			
R.			
PE.			
G.			
T.D.	<u>5004</u>		

Loc. in Sec. NW NW SW
 Geol. _____
 Contr. Hulme Drlg.
 Pool Miller

Lse.

ABANDONED

No.

Date Comm. 11-13-55

DEC 7 1955

Sec.

8" @ 315/250 DST 4493-4520 open 1 hr.

rec. 20' mud 35# DST 4898-4926

open 1/3 hr. rec. 12' mud 55#

DST 4983-5004 open 1 hr. rec. 70' wm

3255' sw 2000#

D & A

T.

R.

County Harper Elev. _____
 Sec. 12 Twp. 33 Rge. 8W
 Company Skelly Oil
 Farm Name Alfred Miller No. 1


TOPS	DEPTH	LOG	DATUM
Anh.			
Tp.			
H.			
Tr.			
Dg.			
Bl.			
L.			
K.C.			
B.K.C.			
Ce.			
C.			
M.			
M.			
K.			
Mz.			
Me.			
V.			
S.			
S.			
A.			
R.			
PE.			
G.			
T.D.			

Loc. in Sec. NW NW SW

Geol. _____
 Contr. Hulme Drlg.

Pool Miller

FIRST REPORT

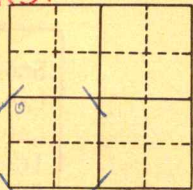

Date Comm. 11-13-55
8" @ 315/250 WOC

NOV 16 1955

27

Co.
Lse.
No.
Sec.
T.
R.