
Harper KANSAS

SECTION 12 TOWNSHIP 33 RANGE 8 W

WELL NO. #1 Sturns "A"

COMPANY Phillips Pet.

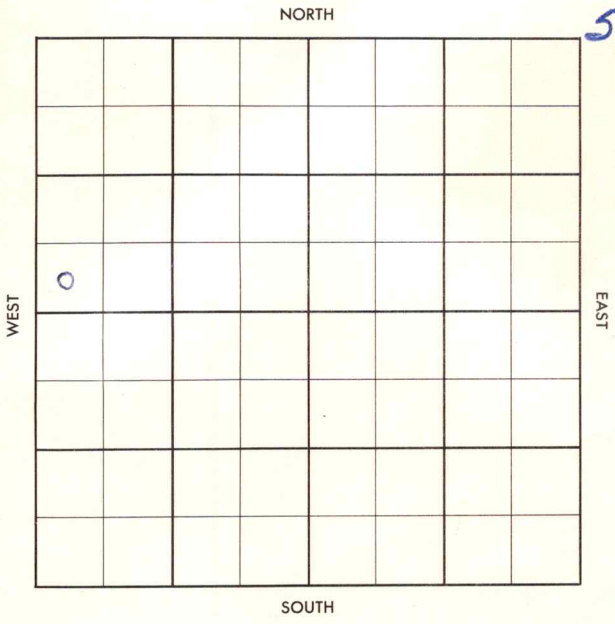

Harper KANSAS

SEC.	TWP.	R.
12	33	8W

WELL NO.

#1 Sturns "A" FARM

COMPANY

Phillips Pet

CONTRACTOR

Garvey
Miller


_____ Ft. from N. Line

_____ Ft. from S. Line

_____ Ft. from E. Line

_____ Ft. from W. Line

SW SW NW

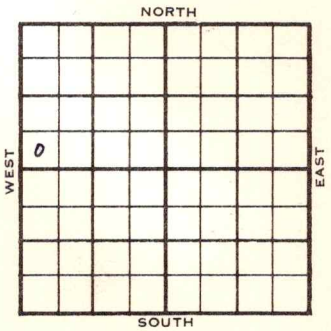

1955	ELEVATION 1367	REPORT

11/16 M I R

12-7 Comm. 11-30-55
9 5/8" @ 258/180
DST 4880-97 op 1 hr. rec. 15' mud, 15/20"
D & A

Tops	Depth	Log
L.	3680	3675
KC	3947	3950
BKC	4154	4161
CE.	4388	4390
M.	4487	4495
K. 4797	~~4888~~	4805
Chatts	4874	4865
Mz	4885	
V.	4886	4890

TD 4892'

ABANDONED

DX-78

FORM 513 REV. SUNRAY

County Harper Elev.

Sec. 12 Twp. 33 Rge. 8W

Company Phillips Pet.

Farm Name Sturns "A" No. 1


TOPS	DEPTH	LOG	DATUM
Anh.			
Tp.			
H.			
Tr.			
Dg.			
B.L.			
L.			
K.C.			
B.K.C.			
Ce.			
C.			
M.			
M.			
K.			
Mz.			
Mq.			
V.			
S.			
S.			
A			
R.			
P€.			
G.			
T.D.			

Loc. in Sec. SW SW NW

Geol.

Contr. Garvey

Pool Miller

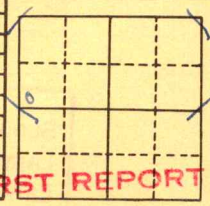

FIRST REPORT

NOV 16 1955

Date Comm.

M I R

Co. Lse. No. Sec. T. R.

27

FORM 513 REV. SUNRAY

County Harper Elev. 1367

Sec. 12 Twp. 33 Rge. 8W

Company Phillips Pet.

Farm Name Sturns "A" No. 1

TOPS	DEPTH	LOG	DATUM
Anh.			
Tp.			
H.			
Tr.			
Dg.			
B.L.			
L.	3680	3675	2308
K.C.	3747	3950	2583
B.K.C.	4154	4161	2794
Ce.	4388	4390	3023
C.			
M.	4487	4495	3128
M.			
K.	4797	4805	3438
Mz. (Cattle)	4874	4865	3498
Mo.	4883		3518
V.	4886	4890	3523
S.			
S.			
A			
R.			
P€.			
G.			
T.D.	4892	4897	

Loc. in Sec. SW SW NW

Geol.

Contr. Garvey

Pool Miller



ABANDONED

DEC 7 1955

Date Comm. 11-30-55

9 5/8" @ 258/180 DST 4880-97

open 1 hr. rec. 15' mud 15/20"

D & A

Co. Lse. No. Sec. T. R.