
KANSAS Stevens County

FORM 51 5M PETROL

Section 8 Township 33 Range 36W

Well No. 1 Cobb

Company Republic Nat. Gas

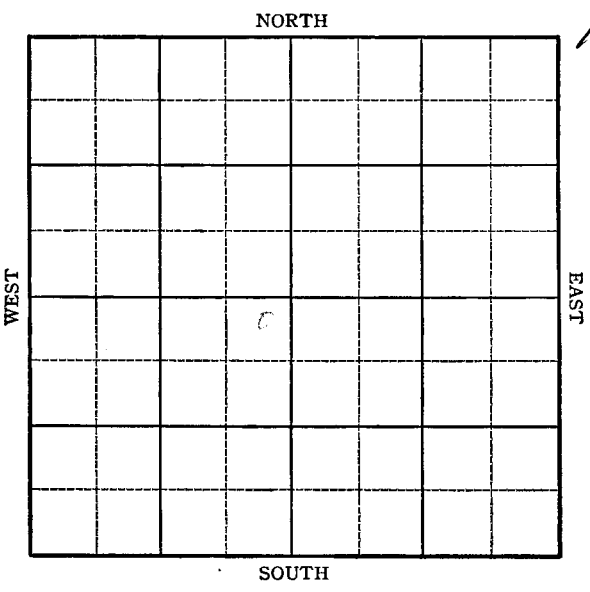

FORM 252 A
5M 9-45 PETROL

KANSAS Stevens

Sec. 8 Twp. 33 R. 36-W

Well No. #1 Cobb Farm

Republic Nat. Gas Company

Hugoton


50 Ft. from N. Line

_____ Ft. from S. Line

60 Ft. from E. Line

~~60~~ Ft. from W. Line

NE SW Elev. 3054

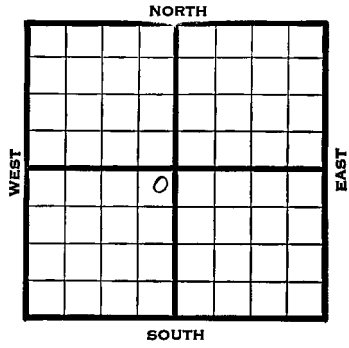

1945	REPORT
7/3	Location
7/11	10" @ 554 Drlg. 2030'
7/19	7" @ 2590 TD 2603' RUST
7/26	Drlg. 2690'
8/1	" "
8/8	" "
8/15	" "
8/22	TD 2820
8/29	" "
9/5	" "
9/12	" "
9/19	" "
9/26	" "
10/3	2500 acid.
10/10	9000 acid.
10/17	7" @ 2590 12,500 acid TD 2820 21,108,000 Gas. 384# R Pr.

COMPLETED

FORM 26 200 BKS 1-44 PETROL

KANSAS

Kansas Pool Name Hugoton

Map No. [illegible] Sec. 8 Twp. 33 R. 36W

Well No. 1 Cobb


Republic Nat. Gas Company

COMPLETED Contractor

NE SW

E 1,3054

SECTION PLAT

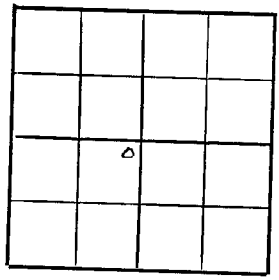

50 Ft. from N. Line

Ft. from S. Line

60 Ft. from E. Line

Ft. from W. Line

Stevens County

Location

Rig up

Drilling and Remarks:

7" @ 2590

12000 acid

24,108,000 Gas

384* R.P.

RECORD

Cased in., ft.

Sand

Gas

Oil

Total Depth 2820

PRODUCTION

1st 24 hrs. Nat.

1st 24 hrs. after shot

Gas Cu. Ft.

Dry Hole

Abandoned

Date

OCT 17 1945

19 S. J. LEWIS Scout

FORM 26 200 BKS 1-44 PETROL

KANSAS

Kansas

Pool Name Hugoton

Map No. (illegible) Sec. 8 Twp. 33 R. 36W


Well No. 1 Cobb

Republic Nat. Gas Company

FIRST REPORT Contractor

NE SW

SECTION PLAT

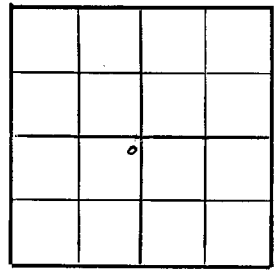

50 Ft. from N. Line

Ft. from S. Line

60 Ft. from E. Line

Ft. from W. Line

Stevens County

Location x

Rig up

Drilling and Remarks:

RECORD

Cased in., ft.

Sand

Gas

Oil

Total Depth

PRODUCTION

1st 24 hrs. Nat.

1st 24 hrs. after shot

Gas Cu. Ft.

Dry Hole

Abandoned

Date

JUL 3 1945 19

S. J. LEWIS Scout