


Section 8 Township 33 Range 35 W

Well No. 1 Crawford

Company Northern Nat. Gas.

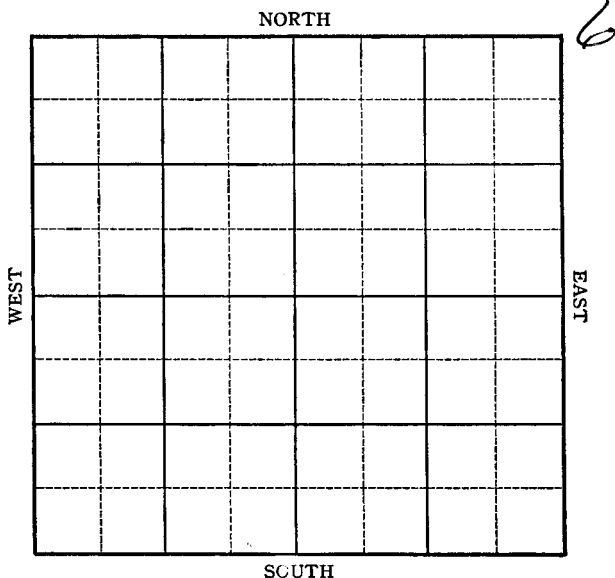

Sec. 8 Twp. 33 R. 35W

Well No. #1 Crawford Farm

Northern Nat. Gas Company


Hugoton

 Ft. from N. Line

100 Ft. from S. Line

100 Ft. from E. Line

 Ft. from W. Line

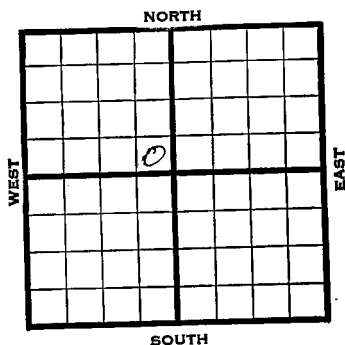

SE NW Elev. 2980

1945

REPORT

7/25	Location
8/1	10" @ 732
	Drlg. 1770
8/8	7" @ 2636
	TD 2647 RUST
8/15	" " "
8/22	" " "
8/29	" " "
9/5	" " "
9/12	" " "
9/19	" " "
9/26	" " "
10/3	" " "
10/10	TD 2647'
10/17	TD 2800
	184' of 5" liner @ 2800
10/24	12,500 acid.
10/31	" "
11/7	7" @ 2636
	184' of 5" Perf. liner @ 2800
	12500 acid.
	TD 2880
	16,784,000 Gas.
	413# R Pr.

COMPLETED


KANSAS Pool Name Hugoton
 Map No. 200 map Sec. 8 Twp. 33 R. 35W
 Well No. 1 Crawford

Northern Nat. Gas Company

FIRST REPORT Contractor

SE NW

SECTION PLAT

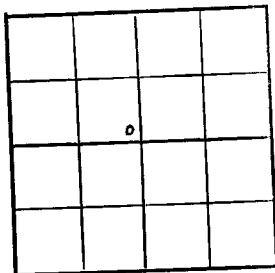

 Ft. from N. Line

100 Ft. from S. Line

100 Ft. from E. Line

 Ft. from W. Line

Stevens County

Location X

Rig up

Drilling and Remarks:

RECORD

Cased in., ft.

Sand

Gas

Oil

Total Depth

PRODUCTION

1st 24 hrs. Nat.

1st 24 hrs. after shot

Gas Cu. Ft.

Dry Hole

Abandoned

Date

JUL 25 1945 19

S. J. LEWIS Scout

KANSAS

Kansas Pool Name HarstonMap No. 10 Sec. 8 Twp. 33 R. 35WWell No. 1 Crawford

Northern Nat. Gas

Company


COMPLETED

Contractor

E1, 2980

SE NW

SECTION PLAT

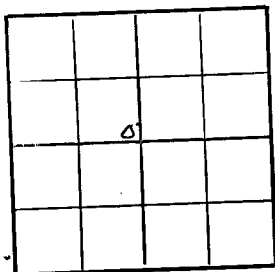

Ft. from N. Line

100

Ft. from S. Line

100

Ft. from E. Line

Ft. from W. Line

Stevens County

Location

Rig up

Drilling and Remarks:

7" @ 2636

184' 5" Pay liner

@ 2800

12500 aciol

16, 784, 000 Gall

413' R P

RECORD

Cased in, ft.

Sand

Gas

Oil

Total Depth 2800

PRODUCTION

1st 24 hrs. Nat.

1st 24 hrs. after shot

Gas Cu. Ft.

Dry Hole

Abandoned

Date

NOV 7 1945

19

S. J. LEWIS

Scout