
Form 51—5M—1-30—38840

Map No. KANSAS Sec. 8 Twp. 33 R. 37 W

Well No. 3 Ratliff Farm

Argus Co. Company

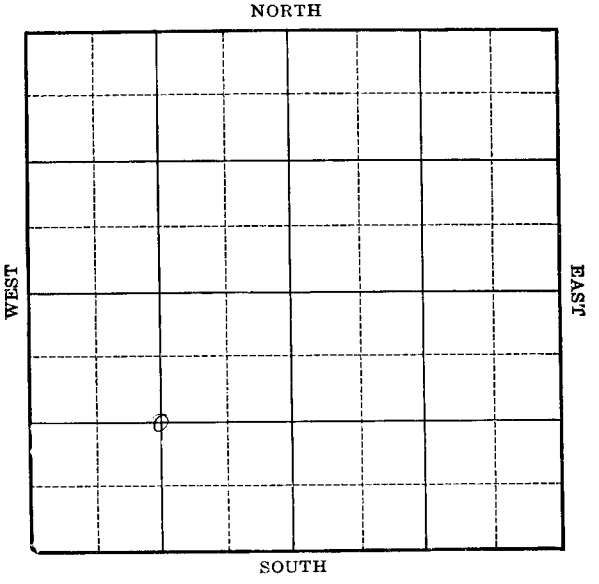

Location

Drilling Remarks

Rig Up

Drilling Remarks

RECORD

Cased ____ in. ____ ft.

Sand

Gas

Oil

Total Depth

PRODUCTION

1st 24 hrs. Nat.

1st 24 hrs. after shot

Gas ____ cu. ft.

Dry Hole

Abandoned


KANSAS
Form 252A—5M—11-29—38055

Stevens

Map No. ____ Sec. 8 Twp. 33 R. 37 W

Well No. 3 – Ratcliff Farm

Argus Gas Company

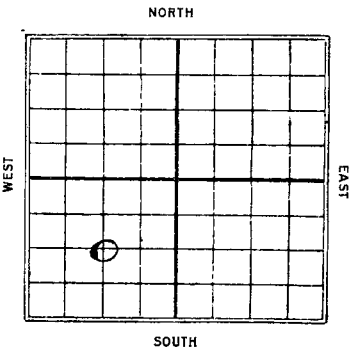

____ Ft. from N. Line

1320 Ft. from S. Line

____ Ft. from E. Line

1320 Ft. from W. Line

Date 1930	REPORT
8/27	Location
9/3	—
9/10	—
9/17	Rig
9/24	Dirt 1055'
10/1	Nodesport
10/8	Rush 2493
10/22	Dirt 2665'
10/29	Sand 2500-2760
	T.D. 2760
	3½ M. Gas
	Comp.

Form 26—1M Bks.—2-29 Stevens

KANSAS

Map No. _____ Sec. 8 Twp. 33 R. 37 W


Well No. 3 Ratcliff

Argus Gas Co Company

_____ Contractor

FIRST REPORTS

SECTION PLAT

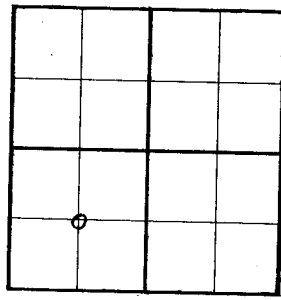

_____ Ft. from N. Line

1320 Ft. from S. Line

_____ Ft. from E. Line

1320 Ft. from W. Line

Location ✓

Rig up _____

Drilling and Remarks:

RECORD

Cased _____ in., _____ ft.

Sand _____

Gas _____

Oil _____

Total Depth _____

PRODUCTION

1st 24 hrs. Nat. _____

1st 24 hrs. after shot _____

Gas _____ Cu. Ft.

Dry Hole _____

Abandoned _____

Date

AUG 27 1930

19

CHAS. L. SHERWOOD

Scout

Form 26—1M Bks. 9-28






Contractor

SECTION PLAT

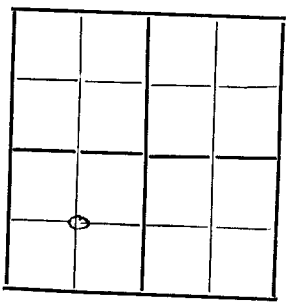

1320 Ft. from N. Line

1320 Ft. from S. Line

Ft. from E. Line

1320 Ft. from W. Line

Location

Rig up

Drilling and Remarks:

RECORD

Cased in., ft.

Sand 2500-2760

Gas 3/4 MM

Oil

Total Depth 2760

PRODUCTION

1st 24 hrs. Nat.

1st 24 hrs. after shot

Gas Cu. Ft.

Dry Hole

Abandoned

Date

192

Scout