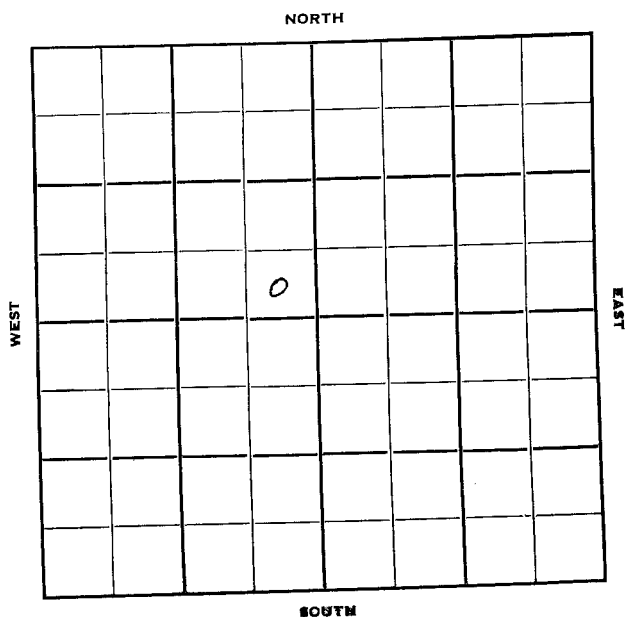


Section 8 Township 33 Range 33WWell No. #1-8 BryantCompany Cabot Carbon

Seward

KANSAS

33W

Sec. 8 Twp. 33 R. 33W

Well No. #1-8 Bryant Farm

Cabot Carbon Company

Contractor

Hugoton Pool


Ft. from N. Line

330' Ft. from S. Line

330' Ft. from E. Line

Ft. from W. Line

SE SE NW

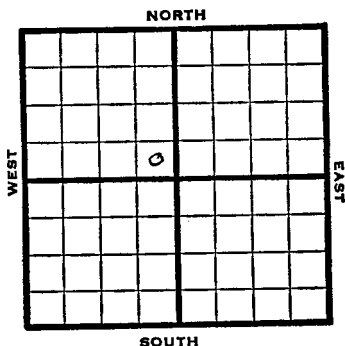

1950 ELEV 2813' REPORT

9/27 Location

12/6 7" @ 2541

TD 2648

PB 2633

Krider 2641

Comp 14,368,000 gas 434#

Completed

County **Seward** State **Kansas**

Sec. 8 (Blk. 33) (Sur. 33W) Map No. _____

Operator **Cabot Carbon**

Well No. **1-8** Farm **Bryant**

Elev.	Location	SE	SE	NW
-------	----------	----	----	----

0

FIRST REPORT

330 Ft. From **S** Line **NW**

330 Ft. From **E** Line Quarter

1st. Report SEP 27 1950

Completion

Remarks

Spudding Date

Drig. Data Hugoton Pool

Location

J. E. TYRA


County Ceward State Kansas

Sec. 8 (Blk.) 33 (Sur.) 53N Map No.

Operator Cabot Carbon

Well No. 1-3 Farm Dryant

Elev. 2813 Location SH 55 N

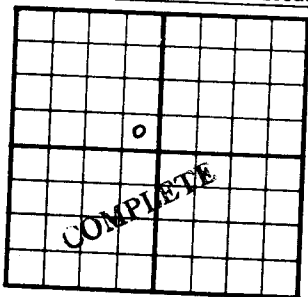

350 Ft. From S Line 33

330 Ft. From 3 Line Quarter

Ist. Report

Completion DEC 6 1950

Remarks Hydroton Pool

Spudding Date 9-23-50

Drilg. Data Gas well TD 2642

7" 2541 TD 2642 FD 2653 Frider 2641

Comp. 14,362,000 lbs 4344

J. E. TYRA