

Company K & E Drlg. Derby Oil & C & G Drlg.

NORTH

WEST

EAST

SOUTH

16

0

Harper KANSAS

SEC.	TWP.	R.
17	33	9W ✓

WELL NO.

1 Crisfield Townsite

FARM

COMPANY

K & E Drlg., Derby Oil & C & G Drlg.

CONTRACTOR

Wildcat


_____ Ft. from N. Line

330 _____ Ft. from S. Line

990 _____ Ft. from E. Line

_____ Ft. from W. Line

SW SE SE

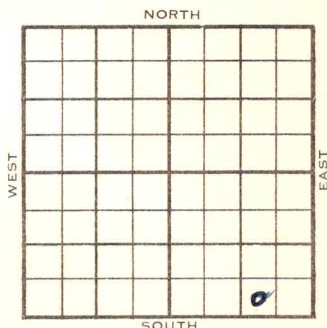

	ELEVATION	REPORT
1954	1368'	

6/23 8" @ 195', WOC

6/30 ∅ 2798

7/7 Howard 2850 Elgin 3272 Oread 3367
Heeb 3410
DST 3454-80 1 hr 680' SW 1588#
Drlg. 3226

7/21 Spud 6-21-54

D&A

TD 4830'

8" @ 195'

Howard 2850', Elgin 3272', Oread 3367',
Heeb 3410'

DST 3454-80', opn 1 hr., rec. 680' SW,
1508#

Lans 4008', Miss 4459'

DST 4459-80', opn 1½ hrs., rec. 145'
muddy sw, 1730#

Viola 4727'

DST 4728-60', opn 1 hr., rec. 12' GCM,
150' muddy SW, 1600#

Simp. 4809, Simp. sd 4811'

DST 4807-20', opn 1 hr., rec. 90'
gcm, 123' SW, 1700#

TD 4830'

D&A

ABANDONED

County	Harper		State	Kansas
Sec.	17	(Blk. Twp.)	33	(Sur. Rge.) 9W Map No.
Operator	K & E Drlg., Derby Oil & C & G Drlg			
Well No.	1	Farm	Crisfield Townsite	
Elev.	Location		SW SE SE	

FIRST REPORT

330	Ft. From	S	Line	SE
990	Ft. From	E	Line	Quarter

1st. Report **JUN 23 1954**

Completion

Remarks

Spudding Date

Drlg. Data

Wildcat

8th @ 195 WOC

J. G. MCGEE

County Harper State Kansas
 Sec. 17 (Blk. 33) (Sur. 9W) Map No.
 Operator K & E Drlg., Derby Oil & C & G Drlg
 Well No. 1 Farm Crisfield Townsite
 Elev. 1368 Location SW SE SE



330 Ft. From S Line SE
990 Ft. From E Line Quarter

1st. Report

Completion JUL 21 1954

Remarks Wildcat

Spudding Date 6-21-54

Drlg. Data D & A TD 4830

8" @ 195 Howard 2850 Elgin 3272

Oread 3367 Heeb. 3410 DST 3454-80

open 1 hr. Rec. 680' sw 1508#

Lans. 4008 Miss. 4459 DST 4459-80

open 1½ hr. Rec. 145' muddy sw 1730#

Viola 4727 DST 4728-60 open 1 hr.

Rec. 12' gcm 150' muddy sw 1600#

Simp. 4809 Simp. sd. 4811 DST 4807-20

open 1 hr. Rec. 90' gcm 123' sw

1700# TD 4830

D & A

J. G. McGEHEE