


FORM 51 Morton

Section 9 Township 33 Range 12W

Well No. #1 Austin "A"

Company Cities Service & Texas (1/8)

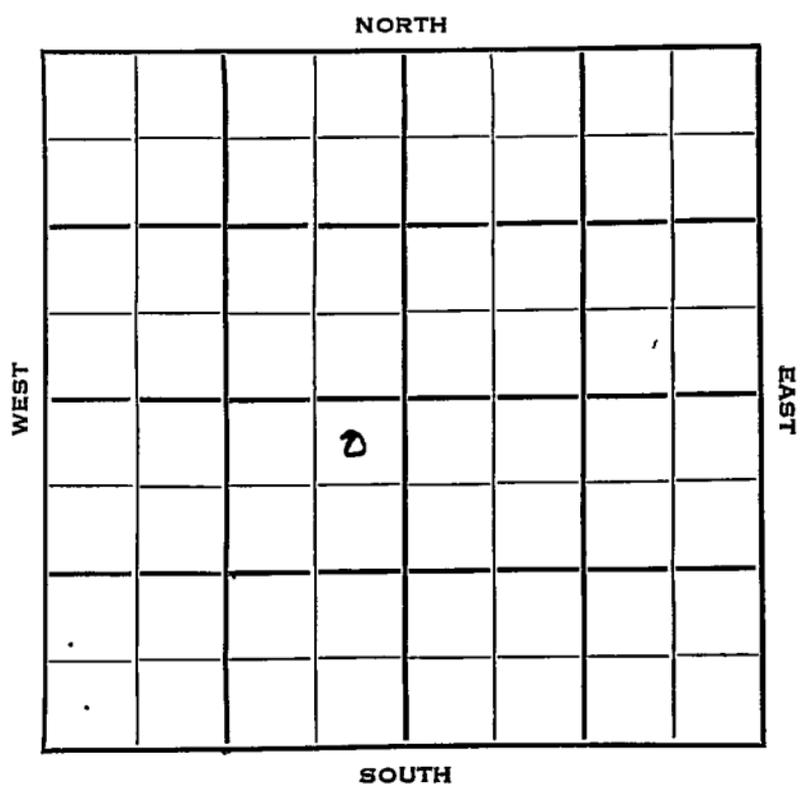

Morton

Sec. 9 Twp. 33 R. 12W

Well No. #1 Austin "A" Farm

Cities Service & Texas (1/8) Company


Contractor

330 Ft. from N. Line

Ft. from S. Line

330 Ft. from E. Line

Ft. from W. Line

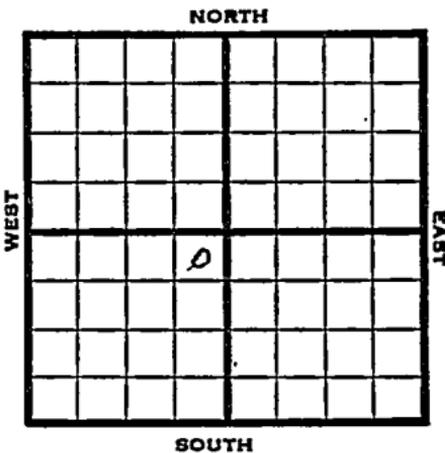

NE NE SW

1953 Elev. 3492' REPORT

2/18 Spudding Date 2/14/53
8" @ 320 Drlg. 1500

2/26 Flow 3" Strem wtr from 525 sq w/325
DST 3900-2960 1 Hr. gas in 36 " 272 GCM
Drlg. 3010

3492 3492
 2876 312 -

 + 616 + 360

3/12 "

3/19 NR

3/26 "

4/2 "

4/9 NR

4/15 Spud 2-14-53
Gas Well
TD 3409'
8" @ 320'
DST 2900-60 open 1 hr. 35 min, gas in
36 min, 70,000 gas 1 hr. 106,000 gas
in 95 min. 270' gcm 480#
Top 2876, Lans 3132,
TD 3409
5" @ 3340'
CO to 3311
20/ 3204-08 20/ 3193-97 30/ 3180-86
50/ 3164-74 90,000 gas 80/ 3136-52
784,000 gas 7500 A 5,540,000 gas

OVER

1953

Information brought forward

4/15 PB 3077 80/ 3024-40 20/ 3014-18
3000 A 16 hr. blow down 16 $\frac{1}{2}$ mcfg
2000 A 14 hr. blow down 18,900,000
gas PB 2983 50/ 2942-52 30/ 2922-28
30/ 2908-14 3000 A 17 hr. blow
down 3 mcfg 3000 A CO to 3308
6 hr. blow down 20,700,000 gas 3000 A
6 hr. blow down 21,900,000 gas
Comp. 24,400,000 gas 433#

COMPLETED

