


SECTION 9 TOWNSHIP 33 RANGE 42W
WELL NO. #2 Auten "A" (*Austin*)
COMPANY Cities Service

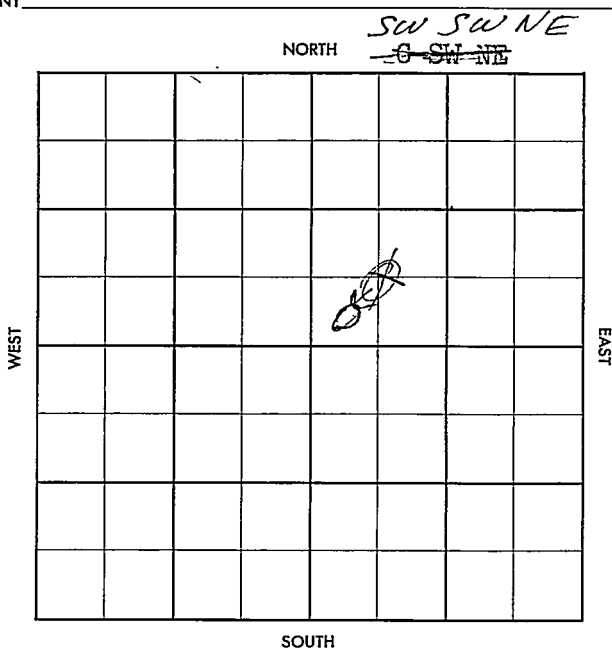

CORRECTION

FORM 513 SUNRAY

County Morton Elev. 5511
 Sec. 9 Twp. 33 Rge. 42W
 Company Cities Service
 Farm Name Antea "A" ~~Antea~~ Austin No. 2

TOPS	DEPTH	LOG	DATUM	Loc. in Sec.
Anh.				<u>G-SW NE</u>
Tp.	<u>2912</u>			<u>SW SW NE</u>
H.	<u>3232</u>			
Tr.				
Dg.				
Bl.				
L.	<u>3368</u>			
K.C. <u>Marm</u>	<u>3660</u>			Geol.
B.K.C.				Contr.
Ce. <u>Mush</u>	<u>4377</u>			
C.				
M. <u>S-23d</u>	<u>4518</u>			Pool
M. <u>S-3 "</u>	<u>4765</u>			<u>Greenwood</u>
K.				
M. <u>Keyes</u>	<u>4915</u>			
Mo. <u>chest</u>	<u>4950</u>			
V.				
S.				
S.				
A.				
R.				
Pe.				
G.				
	<u>4995</u>			

MAY 15 '57

ABANDONED

Date Comm. MAY 1 '57
 Location 4-26-57 8578
1369/650 45' 57 D5T 3665-3730
55" 860' SW FP 140-480
BHP 760/15" @ 3935 MAY 15 '57
D5T 4520-45 1hr C150" T5TM
acc 60' GCMEO + 450 SW FP
45-245 1400/120" D5T 4767-90
45" acc 40' Md BHP 31.5 D5T
4917-31 1hr acc 65' M5W + 360'

FORM 513-1 SUNRAY

SW FP 0-220 920/154

DEW

9-33-42W

SW SW NW

County Morton Elev. _____
 Sec. 9 Twp. 33 Rge. 42W
 Company Cities Service
 Farm Name Auten HAN No. 2

TOPS	DEPTH	LOG	DATUM	Loc. in Sec.
Anb. <u>0</u>				<u>C SW NE</u>
Tr.				
H.				
Tr.				
Dg.				
BL.				
L.				Geol. _____
K.C.				Contr. _____
B.K.C.				
Ce.				
C.				
M.				Pool _____
M.				<u>Greenwood</u>
K.				
Mz.				
Mo.				
V.				
S.				
S.				
A.				
R.				
Pe.				
G.				
TD.				

FIRST REPORT

APR 24 1957

Date Comm. _____
 Location _____

34