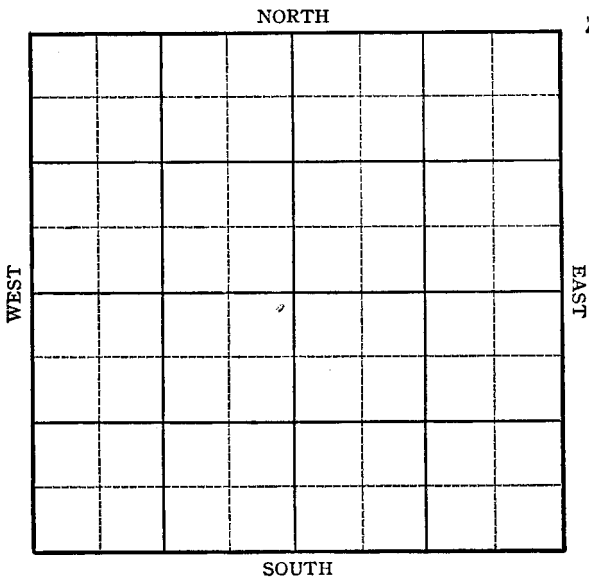


FORM 51 5M PETROL


Section 9 Township 33 Range 36WWell No. 1 BrownCompany Republic Nat. Gas

Sec. 9 Twp. 33 R. 36WWell No. #1 Brown FarmRepublic Nat. Gas Company

Hugoton

100 Ft. from N. Line Ft. from S. Line50 Ft. from E. Line Ft. from W. Line

NE SW Elev. 3036

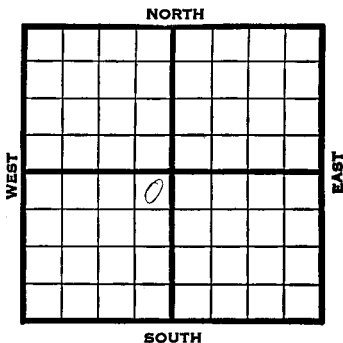

1945

REPORT

7/11 Location
 7/19 Surface Hole
 7/26 10" @ 521
 Drlg. 2400'
 8/1 7" @ 2587
 TD 2600 RUST
 8/8 " " "
 8/15 Drlg. 2614
 3/20 Drlg. 2727
 8/29 TD 2801
 3½ M Gas
 9/5 " "
 9/12 " "
 9/19 7" @ 2587
 226' of 5" Perf. liner @ 2801
 10,000 Acid
 TD 2801
 25,310,000 Gas
 387# R Pr.

COMPLETED

KANSAS


Kansas Pool Name HugotonMap No. 2200 Sec. 9 Twp. 33 R. 36WWell No. 1 BrownRepublic Nat. Gas. Company

FIRST REPORT

Contractor

NE SW

SECTION PLAT

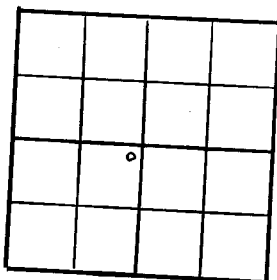100 Ft. from N. Line Ft. from S. Line50 Ft. from E. Line Ft. from W. LineStevens CountyLocation XRig up

Drilling and Remarks:

RECORD

Cased in., ft.Sand Gas Oil Total Depth

PRODUCTION

1st 24 hrs. Nat. 1st 24 hrs. after shot Gas Cu. Ft.Dry Hole Abandoned

Date

JUL 1 1 194519S. J. LEWIS Scout

Kansas Pool Name Hugoton
 KANSAS
 Map No. no map Sec 9 Twp. 33 R. 36W
 Well No. 1 Brown

Republic Nat. Gas Company

COMPLETED

Contractor

NE SW


E1,3096
 SECTION PLAT

100 Ft. from N. Line

_____ Ft. from S. Line

50 Ft. from E. Line

_____ Ft. from W. Line

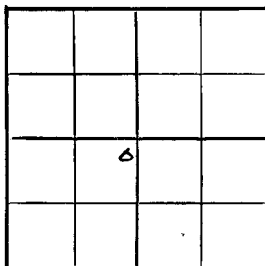

Stevens County

Location _____

Rig up _____

Drilling and Remarks:

7" C2587
 226' of 5" Pay lines
 C2501
 10000 ac oil
 25,310,000 Gas
 387# RP₂

RECORD

Cased _____ in., _____ ft.

Sand _____

Gas _____

Oil _____

Total Depth 2801

PRODUCTION

1st 24 hrs. Nat. _____

1st 24 hrs. after shot _____

Gas _____ Cu. Ft.

Dry Hole _____

Abandoned _____

Date

SEP 19 1945

19

S. J. LEWIS

Scout