34- 34- 1W

WELL LOG BUREAU—KANSAS GEOLOGICAL SOCIETY
508 East Murdock, Wichita, Kansas


Company. HERNDON DRILLING COMPANY
Farm. McProud No. 1

SEC. 34 T. 34 R. 1W
SE SE SE

Total Depth. 4279
Comm. 2-17-53 Comp. 2-28-53
Shot or Treated.
Contractor.
Issued. 3-28-53

County Sumner KANSAS

CASING:
8 5/8" 302' cem. w/225 sx

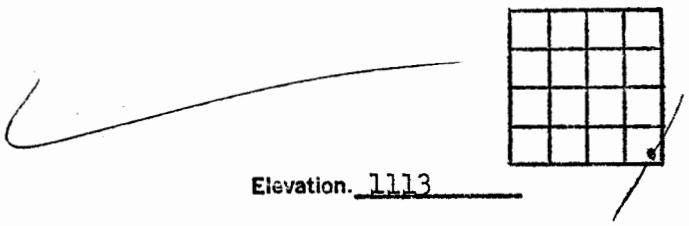

Elevation. 1113

Production. Dry

Figures Indicate Bottom of Formations.

shale & sand	302
shale & shells	810
lime & shale	2632
sand & shale	3406
shale & lime	3450
lime	3710
lime & shale	3830
lime	3970
lime & chert	4035
lime	4240
shale	4279
Total Depth	

Tops:

Layton Sand	3200
Miss. Chat	3913
Lime	3940
Misener	4259
Simpson	4264

No shows