

Barber


KANSAS

SECTION 1 TOWNSHIP 34 RANGE 13 W

WELL NO. #1 R. H. Donovan

COMPANY Magnolia Pet.

NORTH

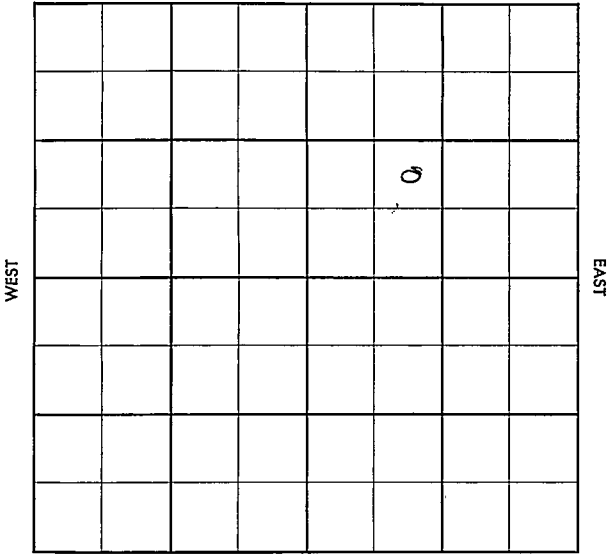

SOUTH

| | | |
|-----------|------------|-----------|
| SEC. 1 | TWP. 34 | R. 13W |
|-----------|------------|-----------|

WELL NO. #1 R.H. Donovan FARM

COMPANY Magnolia Petr.

CONTRACTOR

Driftwood


_____ Ft. from N. Line

_____ Ft. from S. Line

_____ Ft. from E. Line

_____ Ft. from W. Line

NE SW NE

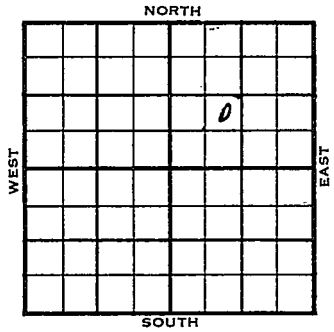

| 1956 | ELEVATION | REPORT |
|------|-----------|--------|
| | 1539 | |

2-29

Loc.

5-2

Comm. # 3-18-56
 9 5/8" @ 356 w/300
 5 1/2" @ 4626 w/150
 DST 4626-55 op 1 hr. rec. 15' mud, 0/20"
 XO 500 A, SP 4627, 18/ 4623-26, 250 A
 frac, 877 mcfg
 CO to 4668, 78/ 4639-64,
 SP 4635, 5000 A
 F/ 600 mcfg, SP 4600, frac
 F/ 5,210 mcfg,
 F/ 5,412 mcfg.
 Comp. open flow 7,820 mcfgpd, 1622#
 L. 3955
 M. 4612
 TD 4675'

COMPLETED

County Barber Elev. _____
 Sec. 1 Twp. 3h Rge. 13W
 Company Magnolia Pet.
 Farm Name R. H/ Donovan No. 1

Co.

| TOPS | DEPTH | LOG | DATUM | Loc. in Sec. |
|--------|-------|-----|-------|--------------|
| Anh. | | | | NE SW NE |
| TP. | | | | |
| H. | | | | |
| Tr. | | | | |
| Dg. | | | | |
| Bl. | | | | |
| L. | | | | Geol. _____ |
| K.C. | | | | Contr. _____ |
| B.K.C. | | | | |
| Ce. | | | | |
| C. | | | | |
| M. | | | | Pool _____ |
| M. | | | | Driftwood |
| K. | | | | |
| Mz. | | | | |
| Mo. | | | | |
| V. | | | | |
| S. | | | | |
| S. | | | | |
| A. | | | | |
| R. | | | | |
| PE. | | | | FIRST REPORT |
| G. | | | | |
| TD. | | | | |

Lse.

| | | |
|--|------------|--|
| | FEB 29 '56 | |
| | 0 | |
| | | |

No.

Sec.

T.

R.

Date Comm. _____
 Location _____

20

| | | | |
|----------|---------------|-------|------|
| County | Barber | Elev. | 1539 |
| Sec. | 1 | Twp. | 34 |
| | | Rge. | 13W |
| Company | Magnolia Pet. | | |
| FarmName | R. H. Donovan | No. | 1 |

| TOPS | DEPTH | LOG | DATUM | Loc. in Sec. |
|--------|-------|-----|-------|--------------|
| Anh. | | | | NE SW NE |
| Tr. | | | | |
| H. | | | | |
| Tr. | | | | |
| Dg. | | | | |
| Bl. | | | | |
| L. | 3955 | | 2416 | Geol. |
| K.C. | | | | Contr. |
| B.K.C. | | | | |
| Ce. | | | | |
| C. | | | | |
| M. | 4612 | | 3073 | Pool |
| M. | | | | Driftwood |
| K. | | | | |
| Mz. | | | | |
| Me. | | | | |
| V. | | | | |
| S. | | | | |
| S. | | | | |
| A. | | | | |
| R. | | | | |
| Pe. | | | | |
| G. | | | | |
| TD. | 4675 | | | |

Date Comm. 3-18-56 MAY 2 1956

9 5/8" @ 356/300 5 1/2" @ 4626/150

DST 4626-55 open 1 hr. rec. 15' mud

0/20" CO 500 A SP 4627

18/ 4623-26 250 A frac 877 mcfg

CO to 4668 78/ 4639-65 SP 4635

5000 A F/ 600 mcfg SP 4600 frac

F/ 5,210 mcfg F/ 5,412 mcfg

Comp. open flow 7,820 mcfgpd 1622#