

Seward

KANSAS

SECTION 1 TOWNSHIP 34S RANGE 33W

WELL NO. #1 Webb


COMPANY Villines

NORTH

C NW/4

WEST

EAST

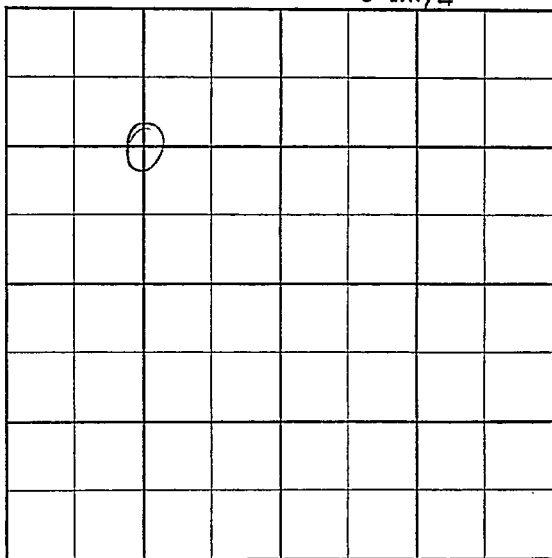

SOUTH

22

County Seward Elev. _____
 Sec. 1 Twp. 34 Rge. 33W
 Company Villines
 Farm Name Webb No. 1

TOPS	DEPTH	LOG	DATUM
Anh.			
Tp.			
H.			
Tr.			
Dg.			
B.L.			
L.			
K.C.			
B.K.C.			
Ce.			
C.			
M.			
M.			
K.			
Mz.			
Mq.			
V.			
S.			
S.			
A.			
R.			
Pf.			
G.			
T.D.			

Loc. in Sec. _____

C NW/4


Geol. _____

Contr. _____

G-M Tools #5

Pool _____

Hugoton

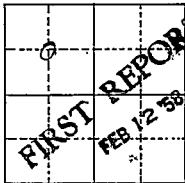

Date Comm. _____

MIRT

Co.

Lse.

No.

Sec.

T.

R.

Twp. X Pool X
 Co. X Facet X

5-513-B

County Seward Elev. 2815 2812
 Sec. 1 Twp. 34 Rge. 33W
 Company Villines
 Farm Name Webb No. 1

TOPS	DEPTH	LOG	DATUM
Anh.			
Tp. <u>HEAD</u>		<u>2617</u>	
H. <u>UKRID</u>		<u>2644</u>	
Tr. <u>LKRID</u>		<u>2671</u>	
Dg.			
B.L.			
L.			
K.C.			
B.K.C.			
Ce.			
C.			
M.			
M.			
K.			
Mz.			
Mq.			
V.			
S.			
S.			
A.			
R.			
Pf.			
G.			
T.D.	<u>2710</u>		

Loc. in Sec. _____

C NW/4

Geol. _____

Contr. _____

G-M Tools #5

Pool _____

Hugoton

COMPLETED
 MAR 27 1958

Date Comm. 2-11-58 F O PAH

MIRT FEB 19 58 8" 634/300 5 1/2"

2709/300 wact FEB 26-58 CO

MAR 5 58 2685 8/2673- 1

NS 8/2675 Ngaa B-P 2668

32/2650-58 1/2 ga 158 MCF

5 vac 15x7 1/2 ga 1.635 mcf

B-P 2640 24/2626-32 24/

2610-24 ga 451 mcf net 1/2 ga

1.221 mcf CO 2685 ga 1.841 mcf

+79wph 8th. SI 72-20

FORM 513-1 SUNRAY

MAR 19 '58 MAR 26 '58 72-20 5.000mg

RP 420A PB 2685

~~2685~~

2685-75