

Section 1 Township 34 Range 34-WWell No. #1 HackerCompany Cabot Carbon

NORTH

				0			

WEST

EAST

SOUTH

Seward

KANSAS

Sec. 1 Twp. 34 R. 34-W ✓

Well No. #1 Hacker Farm

Cabot Carbon Company

Contractor

Hugoton


330 Ft. from N. Line

         Ft. from S. Line

         Ft. from E. Line

330 Ft. from W. Line

NW NW SE

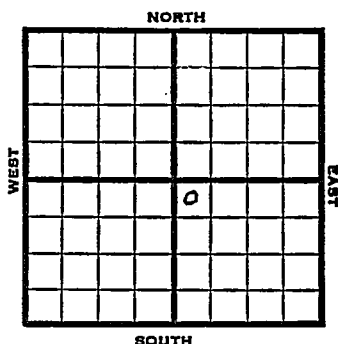

1951 Elev 2983' REPORT

1/3 Location

3/14 Spud 12-23-50

Gas well TD 2686'  
10" @ 610, 7" @ 2614, TD 2686'  
Her. 2615, Krider 2630,  
23,000 A  
Comp. 13,408,000 gas 429#

**COMPLETED**



Sec. **1** (Blk. **34** (Sur. **34W** Map No.

Well No. **1** Farm **Hacker**

Elev. 2983 Location NW NW SE

FIRST REPORT

330 Ft. From N Line SE

330 Ft. From W Line Quarter

1st. Report JAN 3 1951

### Completion

Remarks


Spudding Date \_\_\_\_\_

Drig. Data Hugoton Pool

### Location

J. E. TYRA

County Seward State Kansas  
 Sec. 1 (Blk.) 34 (Sur.) 34W Map No.       
 Operator Cabot Carbon  
 Well No. 1 Farm Hacker  
 Elev. 2983 Location NW NW SE

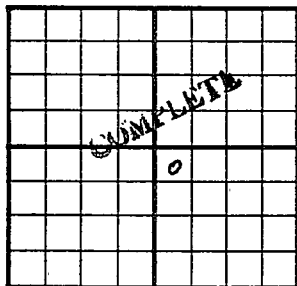

330 Ft. From N Line SE  
330 Ft. From W Line Quarter  
 Ist. Report       
 Completion MAR 14 1951  
 Remarks Hugoton Pool

Spudding Date 12-23-50  
 Drlg. Data Gas well TD 2686  
10" @ 610 7" @ 2614 TD 2686  
Her. 2615 Krider 2630 23000 A  
Comp. 13,408,000 gas 429#

J. E. TYRA