


KANSAS

Stevens

Section 1 Township 34 Range 35WWell No. 1 WheelerCompany TexasHugoton

NORTH

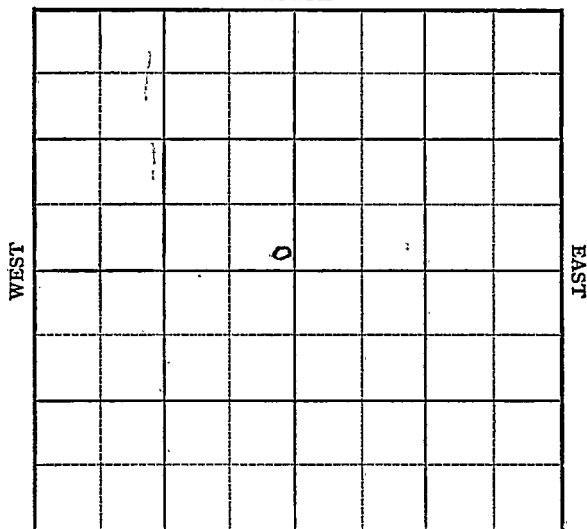

SOUTH

KANSAS

Stevens

Sec. 1 - Twp. 34 R. 35W ✓

Well No. #1 Wheeler Farm

Texas

Hugoton Pool Company

 Ft. from N. Line

165'


 Ft. from S. Line

165'

 Ft. from E. Line

 Ft. from W. Line

SE NW

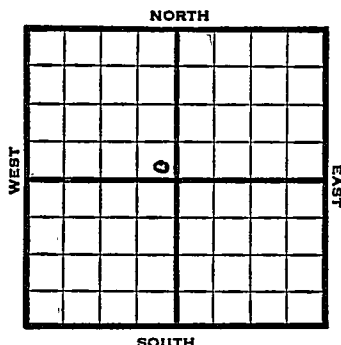

1949 Elev 2974' REPORT

5/25 Drlg. 729'
6/1 10" @ 741'
Drlg. 2708'
6/7 TD 2808'
7"@ 2806'
6/15 "
6/21 436 shots 2656 - 2800
Add 5000
6/28 Acid 10,000
7/6 TD 2808'
7"@ 2806'
Perf 15000 acid
20,348,000 Gas
390# R Pr.
Comp

COMPLETED

Map No. _____ Sec. 1 Twp. 34 R. 35W

Well No. 1 Wheeler

_____ Texas _____ Company

_____ Contractor

SE NW

FIRST REPORT
SECTION PLAT

_____ Ft. from N. Line

165 Ft. from S. Line

165 Ft. from E. Line

_____ Ft. from W. Line

Stevens County

Location _____

Rig up _____

Drilling and Remarks:

drlg. 729

RECORD

Cased _____ in., _____ ft.

Sand _____

Gas _____

Oil _____

Total Depth _____

PRODUCTION

1st 24 hrs. Nat. _____

1st 24 hrs. after shot _____

Gas _____ Cu. Ft.

Dry Hole _____

Abandoned _____

Date

MAY 25 1949

19

S. J. LEWIS

Scout

Map No. Sec. 1 Twp. 34 R. 35W

Well No. 1 Wheeler

Texas Company

COMPLETE

Contractor

SE NW

E12974
SECTION PLAT

 Ft. from N. Line

165 Ft. from S. Line

165 Ft. from E. Line

 Ft. from W. Line

Stevens County

Location

Rig up

Drilling and Remarks:

7 "C2806

Prof.

15000 Gall C

20, 348, 000 Gall

*350 * R/2*

RECORD

Cased in., ft.

Sand

Gas

Oil

Total Depth 2805

PRODUCTION

1st 24 hrs. Nat.

1st 24 hrs. after shot

Gas Cu. Ft.

Dry Hole

Abandoned

Date

JUL 6 1919

S. J. LEWIS

Scout

Scout Cards

Land Small Map

Land Wall Map

Tracings

France Map

Pierce Map

Misc.

Earth
D