


DX 78-1 Morton

KANSAS

Section 1 Township 34 Range 43W

Well No. 1 Interstate

Company Panhandle Eastern

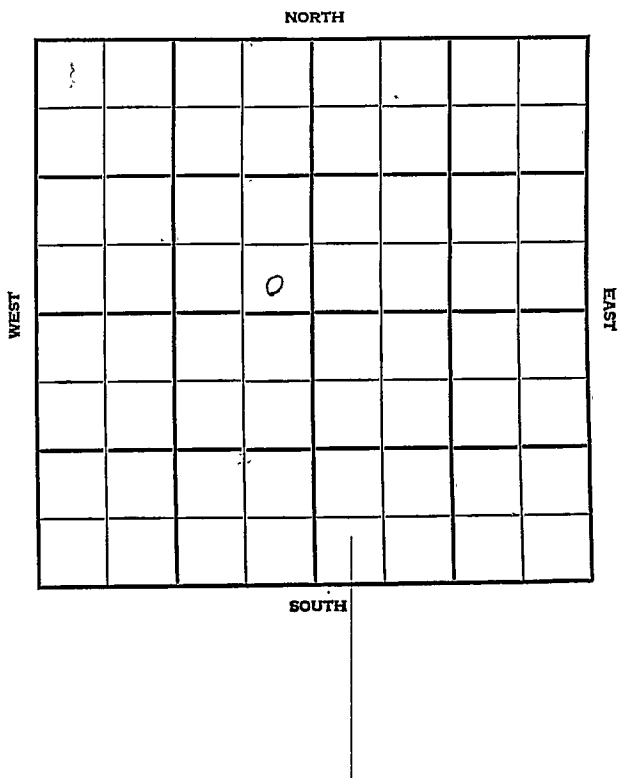

Morton KANSAS

SEC.	TWP.	R.
1	34	13W

WELL NO. 1 Interstate FARM

COMPANY Panhandle Eastern


CONTRACTOR Falcon-Seaboard  
Greenwood Gas Pool

2388 Ft. from N. Line

Ft. from S. Line

Ft. from E. Line

2300 Ft. from W. Line

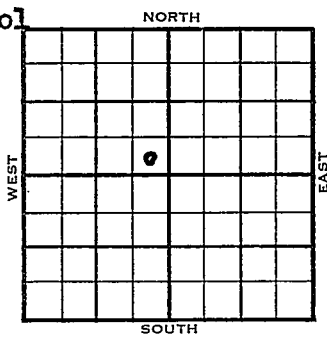

SE SE NW

	ELEVATION	REPORT
--	-----------	--------

1955

4/27

Spud 4-19-55  
10" @ 593'  
Drlg. 2620'

5/25

Wab 2645; Top 2682; Lsg 3111;  
TD 3165; 10" 593; 7" 3156; 1000A  
400,000 cfg; 2000A; plug 3080; perf  
3050-64; no show; perf 2977-94;  
3000A 1,136,000 cfg; 5000A  
plug 2955; perf 2938-44, 2914-28  
2903-07, 2884-92, 2858-66, 8000 A  
plug 2955; 15,273,000 cfg

COMPLETED



MAY

2 1955

Scout Card	_____
Land Small Map	_____
Land Wall Map	_____
Tracing	_____
France Map	_____
Pierce Map	_____
Misc.	_____ <i>a</i>