

Sec. 1 Twp. 34 Range 38 W

#1 Phillips

Kansas Geological Society

Texas Interstate + McNabb

Skelly Scout Tickets

Map No. KANSAS Sec. 1 Twp. 34 R. 38^w

Well No. 1- Phillips Farm

Texas Interstate Oil & Gas Company
M^cKnabb NORTH


1320 Ft. from N. Line

_____ Ft. from S. Line

_____ Ft. from E. Line

1320 Ft. from W. Line

1931

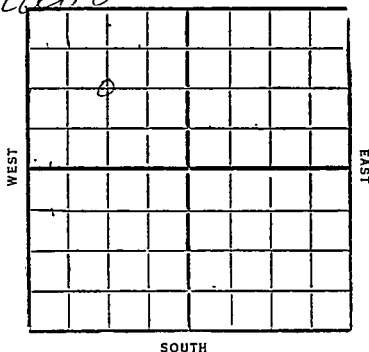

Date 1/14 REPORT LCC

1/21 _____

1/28 _____

2/4 _____

2/11 _____

2/18 _____

2/25 _____

3/4 _____

3/11 Dry 600'

3/18 " 1763'

3/25 " 2206'

4/8 TD 2587' Rust

4/15 Show gas 2600

4/22 Dry 2660'

4/22 Cased 6"-2591

4/22 T.D. 2801

4/22 9 1/2" Gas

4/22 Comp.


Map No. **KANSAS** Sec. 1 Twp. 34 R. 38W

Well No. 1 Phillips

Texas Interstate P. & M. Co. Company

Contractor

SECTION PLAT

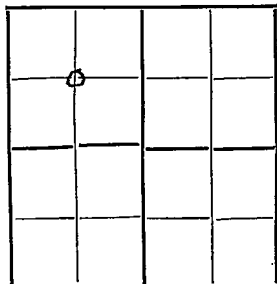

1320 Ft. from N. Line

..... Ft. from S. Line

..... Ft. from E. Line

1320 Ft. from W. Line

FIRST REPORTS

Location ✓

Rig up

Drilling and Remarks:

RECORD

Cased in., ft.

Sand

Gas

Oil

Total Depth

PRODUCTION

1st 24 hrs. Nat.

1st 24 hrs. after shot

Gas Cu. Ft.

Dry Hole

Abandoned

Date

JAN 14 1931

192

S. J. LEWIS Scout

KANSAS

Map No. _____ Sec. 1 Twp. 34 R. 38^WWell No. 1 PhillipsTexas- Interstate Ph Company

Contractor _____


COMPLETE

SECTION PLAT

1320 Ft. from N. Line

_____ Ft. from S. Line

_____ Ft. from E. Line

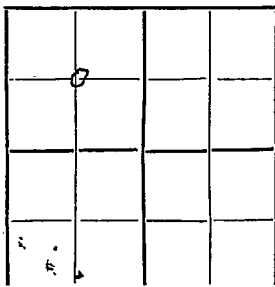1320 Ft. from W. Line

Location _____

Rig up _____

Drilling and Remarks:

* RECORD

Cased 6 in., 7591 ft.

Sand _____

Gas _____

Oil _____

Total Depth 2801

* PRODUCTION

1st 24 hrs. Nat. _____

1st 24 hrs. after shot _____

Gas 9 1/2 M Cu. Ft.

Dry Hole _____

Abandoned _____

Date

APR 22 1931

192

CHAS. L. SHERWOOD

Scout