

Harper

KANSAS


SECTION 10 TOWNSHIP 34S RANGE 8W

WELL NO. #1-Dusenberry

COMPANY Mull Drlg. & Continental

SE SE NW

NORTH

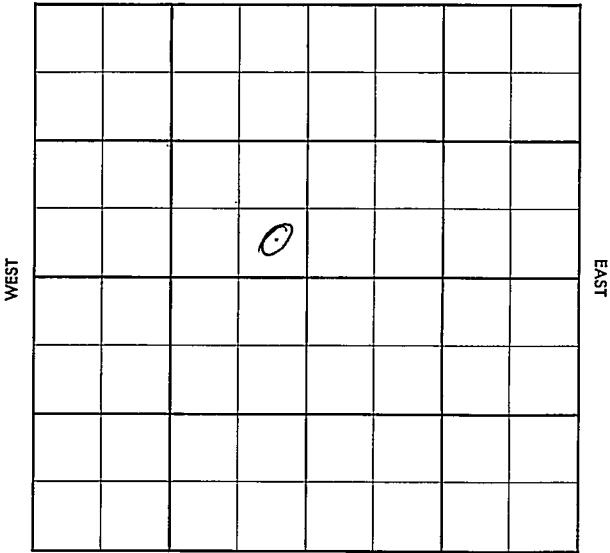

SOUTH

WILDCAT

FORM 513 SUNRA

County Harbor Elev. _____
 Sec. 10 Twp. 3h Rge. 8W
 Company Mill Drlg. & Continental
 Farm Name Dusenberry No. 1

	TOPS	DEPTH	LOG	DATUM
Anh.				
Tp.				
H.				
Tr.				
Dg.				
Bl.				
L.				
K.C.				
B.K.C.				
Ce.				
C.				
M.				
M.				
K.				
Mz.				
Me.				
V.				
S.				
S.				
A.				
R.				
PE.				
G.				
T.D.				

Loc. in Sec. SE SE NW

Geol. _____
 Contr. _____
 Co. tools _____
 Pool Wildcat

FIRST REPORT
 JUN 19 57

Date Comm. 6-14-57
8" @ 240 drlg. 1910

27

Co.
 Sec.
 No.
 Sec.
 T.
 R.

FORM 513 SUNRAY

County Harper Elev. 1343
 Sec. 10 Twp. 34 Rgs. EW
 Company Full Dr. Co. Cont. Ex. 21
 Farm Name Dusenberry No. 1

TOPS	DEPTH	LOG	DATUM	Loc. in Sec.
Anh.				S ^W S ^E NW
Tr.				
Dg.	<u>3442</u>			
Bl.	<u>3469</u>			
L.	<u>3721</u>	<u>3790</u>		
K.C.	<u>4038</u>	<u>4042</u>		Geol.
B.K.C.				Contr.
Ce.				Co. tools
C.				
M.	<u>4593</u>	<u>4591</u>		
M.				Pool
K		<u>4823?</u>		<u>Wildcat</u>
Mz.				
Mq.				
V.		<u>5011</u>		
S.		<u>5059</u>		
S.				
A				
R.				
PE.				
G.				
T.D.	<u>5090</u>			

Date Comm. 6-1-57

8" C 240 irlg. 1,10 W. 17

DST 3472-85 1hr rec 1290MW FP 50-655 BHP 148120" DST 3794-3802 1hrrec 930' GC SW FP 120-540BHP 1520 120" D 4330 42DST ~~4603-20~~ 4420-45 90"2660' GIP rec 30' SGCM BHPFailed DST 4603-20 2hrs

ABANDON

JUL 10 1957

617" ga 84 MCF/10 ga 140
 MCF/2 hrs net 145' SGC M
 BHP 1940 - 1860 DST
~~4640-80~~ DST 4620-40 OR
 90" 990' GIP net 80' SOC
 9554 Md FP 50-50 BHP
 1310 FBHP 110/20" DST
 4640-80 90" net 80' SGE'
 VSOCM FP 60-60 BHP 80/20"
 Ø 5005 JUL 10 '57 DST 5057-66
 OR 2 hrs net 485' VSGCSW
 FP 180 BHP 1700/20"

D & W