


Section 10 Township 34 Range 26W

Well No. #1 D. J. Wilson

Company Rod Oil Co.

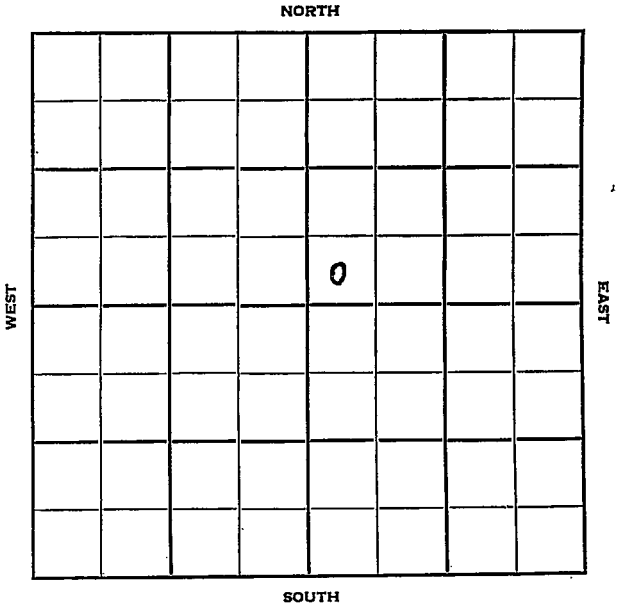

Sec. 10 Twp. 34 R. 26 W

Well No. # 1 D. J. Wilson Farm

Rod Oil Co. Company

Contractor


         Ft. from N. Line

330 Ft. from S. Line

         Ft. from E. Line

330 Ft. from W. Line

SW SW NE

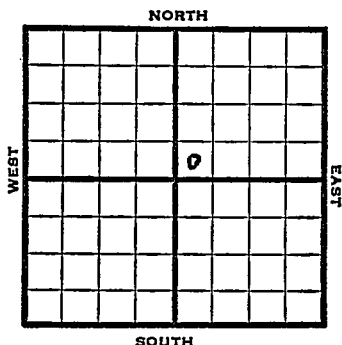

1952

Elev. 2207'

REPORT

8/27 Spud 8-25-52

9/3 Drlg. 2500'

9/10 10" @ 1504 Drlg. 3901

9/17 Lans. 4568'  
Drlg. 4996'

9/24 Marm 5230 Cherokee 5406  
Drlg. 5580

10/1 Morrow 5692' Chester 5727

10/8 Spud 8-25-52  
D & A TD 5882' 10" @ 1504  
Lans. 4568' Marm. 5230'  
Cherokee 5406' Morrow 5692'  
Chester 5727'  
DST 5686-5882 open 1/2 hr, rec 50' SGCM  
TD 5882'  
D & A

**ABANDONED**



County Meade State Kansas

Sec. 10 (Bk.) 34 (Sur.) 2 6W Map No.

Operator Rod Oil Co.

Well No. 1 Farm D. J. Wilson

Elev. 2207 Location SW SW NE

|  |  |  |  |  |
|--|--|--|--|--|
|  |  |  |  |  |
|  |  |  |  |  |
330 Ft. From S Line NE

330 Ft. From W Line Quarter

Ist. Report

Completion OCT 8 1952

Remarks

Spudding Date 8-25-52

Drlg. Data D & A TD 5882

10" @ 1504 Lans. 4568 Marm. 5230

Cherokee 5406 Morrow 5692 Chester 5727

DST 5686-5882 open 1/2 hr. Rec. 50' sgcm

TD 5882

D & A