

Meade


KANSAS

SECTION 10 TOWNSHIP 34 RANGE 30 W

WELL NO. #1 FOX

COMPANY James Donoghue (Denver)

NORTH

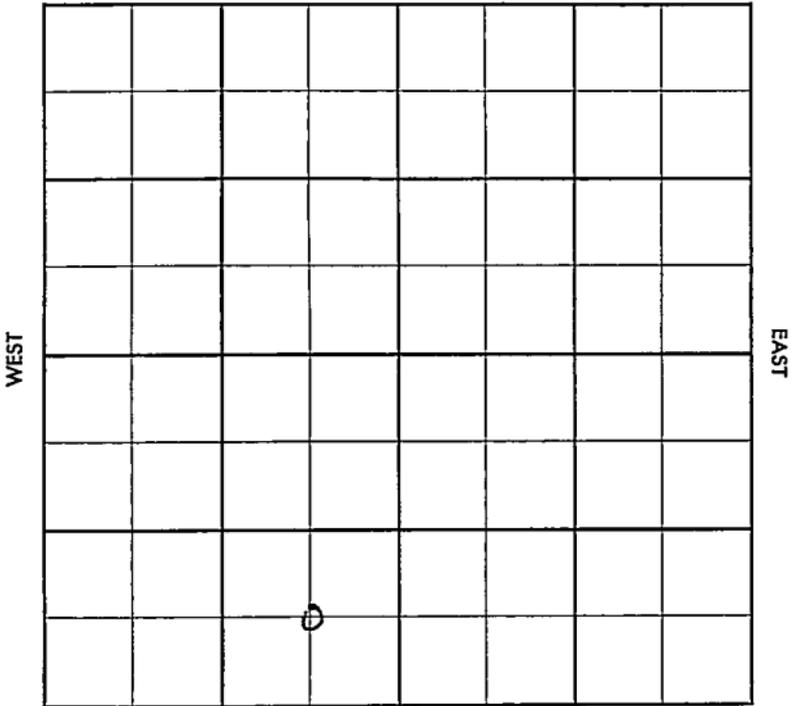

SOUTH

Meade

KANSAS

SEC. 10	TWP. 34	R. 30W
------------	------------	-----------

WELL NO.

#1 Fox

FARM

COMPANY

James Donoghue (Denver)

CONTRACTOR

Rocket

WILDCAT


_____ Ft. from N. Line

_____ Ft. from S. Line

_____ Ft. from E. Line

_____ Ft. from W. Line

C SE SW

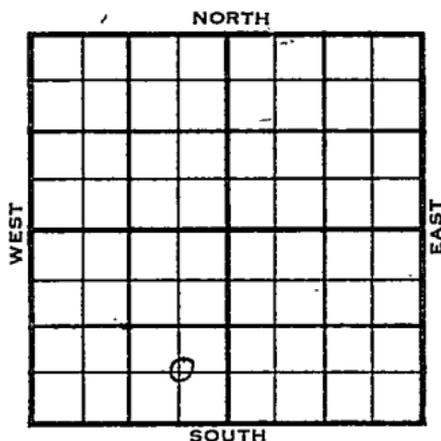

1955

ELEVATION

2681'

REPORT

12-28

Comm. 12-17-55

Miss. test

8" @ 1549/350

Drlg. 2629

1956

2-1

DST 5164-78 op 1 hr. rec. 720' wtr.
1720#DST 5835-6100 op 1 hr. rec. 100' mud,
D & A

Log tops:

Herr. 2694

Kri. 2758

Winf. 2818

Ft. Riley 2884

Tor. 4493

Lans 4608

Marm 5320

Ce. 5476

Stoka 5620

Mw. sh. 5850

Chester 5930

TD 6100'

ABANDONED

County Meade Elev. _____
 Sec. 10 Twp. 34 Rge. 30W
 Company James Donoghue (Denver)
 Farm Name Fox No. 1

TOPS	DEPTH	LOG	DATUM
Anh.			
Tp.			
H.			
Tr.			
Dg.			
Bl.			
L.			
K.C.			
B.K.C.			
Ce.			
C.			
M.			
M.			
K.			
Mz.			
Ma.			
V.			
S.			
S.			
A.			
R.			
Pe.			
G.			
T.D.			

Loc. in Sec. C SE SW
 Miss. test
 Geol. _____
 Contr. Rocket
 Pool Wildcat
 DEC 28 1955
 FIRST REPORT
 0

Date Comm. 12-17-55
8" @ 1549/350 d rlg. 2629

Handwritten signature

Co.
Lse.
No.
Sec.
T.
R.

County Meade Elev. 2681
 Sec. 10 Twp. 34 Rge. 30W
 Company James Donoghue (Denver)
 FarmName Fox No. 1

Co.

Loc.

No.

Sec.

T.

R.

TOPS	DEPTH	LOG	DATUM
Anh.			
Tr.			
H. <u>Herr.</u>		<u>2694</u>	
Tr. <u>Kri</u>		<u>2758</u>	
Dg. <u>Wind</u>		<u>2818</u>	
Bl. <u>J. Killy</u>		<u>2884</u>	
L. <u>Lore</u>		<u>4493</u>	
K.C. <u>Lanad</u>		<u>4608</u>	<u>1927</u>
B.K.C. <u>Manm</u>		<u>5320</u>	<u>2639</u>
Ce.		<u>5476</u>	<u>2795</u>
C. <u>(taken)</u>		<u>5620</u>	<u>2939</u>
M. <u>Murphy</u>		<u>5850</u>	<u>3169</u>
M. <u>Chester</u>		<u>5930</u>	<u>3249</u>
K.			
Mz.			
Mq.			
V.			
S.			
S.			
A.			
R.			
Pe.			
G.			
T.D.	<u>6100</u>		

Loc. in Sec. C SE SW


Geol. _____

Contr. _____

Rocket

Pool _____

Wildcat

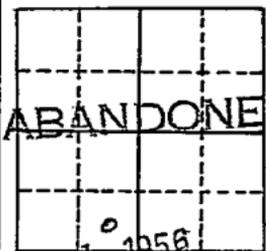

Date Comm. 12-17-55 FEB 1 1956
8^m @ 1549/350 DST 5164-78 open 1 hr.
Rec. 720' wtr. 1720# DST 5835-6100
open 1 hr. rec. 100' mud

D & A