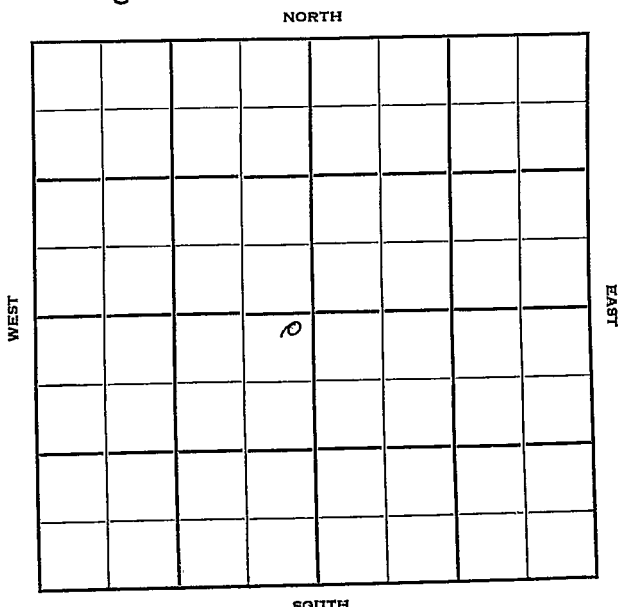


Section 10 Township 34 Range 35-WWell No. #1 Skinner "B"Company C S O
Hugoton Pool

Stevens

KANSAS

Sec. 10 Twp. 34 R. 35W

Well No. #1 Skinner "B" Farm

C SO

Company

McGill

Contractor

Hugoton Pool


100' Ft. from N. Line

Ft. from S. Line

100' Ft. from E. Line

Ft. from W. Line

NE SW

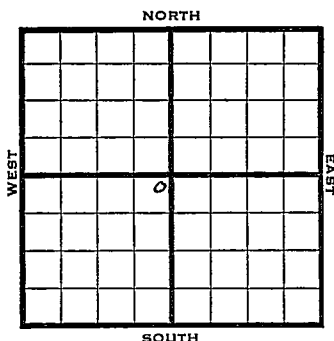

1949 Elev 2991' REPORT

10/26	Location
11/1	10" @ 794'
11/9	TD 2700'
	7" @ 2699'
11/16	2000 acid
	113' of 5" Perf Liner @ 2794'
	TD 2794'
	20000 acid
11/23	Acid 6000
11/29	"
12/7	TD 2794'
	7" @ 2699'
	113' of 5" Perf Liner @ 2794'
	11000 acid
	23,900,000 Gas
	409# R Pr.
	Comp

COMPLETED

Map No. _____ Sec. 10 Twp. 34 R. 35W

Well No. 1 Skinner "B"

C S O Company

McGill Contractor

**FIRST REPORT
SECTION PLAT**

NE SW

100 Ft. from N. Line

_____ Ft. from S. Line

100 Ft. from E. Line

_____ Ft. from W. Line

	0		

Stevens County

Location X

Rig up _____

Drilling and Remarks:

RECORD

Cased _____ in., _____ ft.

Sand _____

Gas _____

Oil _____

Total Depth _____

PRODUCTION

1st 24 hrs. Nat. _____

1st 24 hrs. after shot _____

Gas _____ Cu. Ft.

Dry Hole _____

Abandoned _____

Date

OCT 26 1949 19 S. J. LEWIS Scout

Map No. _____ Sec. 10 Twp. 34 R. 35W

Well No. 1 Skinner "B"

C S O _____ Company

COMPLETE

Contractor

NE SW


E1, 2881
SECTION PLAT

100 Ft. from N. Line

_____ Ft. from S. Line

100 Ft. from E. Line

_____ Ft. from W. Line

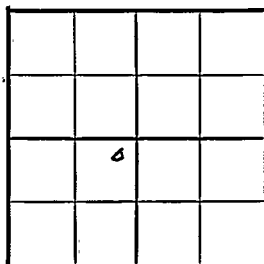

Stevens County

Location _____

Rig up _____

Drilling and Remarks:

7" C2688

113' 8" / 15" Pay Line

C2794

11000 Bad

23,900,000 Gal

*408 * R/S*

RECORD

Cased _____ in., _____ ft.

Sand _____

Gas _____

Oil _____

Total Depth *2794*

PRODUCTION

1st 24 hrs. Nat. _____

1st 24 hrs. after shot _____

Gas _____ Cu. Ft.

Dry Hole _____

Abandoned _____

Date

DEC 7 1949

19

S. J. LEWIS

Scout