


DX 78-1

Section 10 Township 34 Range 43 W

Well No. #1 Interstate

Company Panhandle Eastern

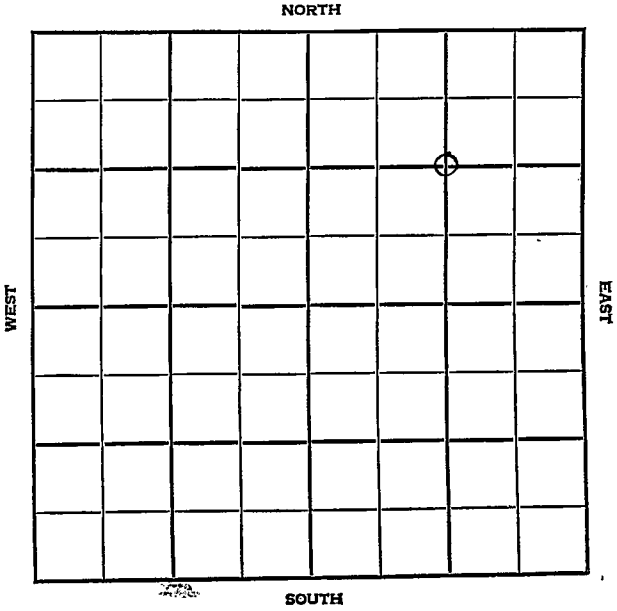

SEP 16 1955

Scout Cards	<i>PH</i>
Land Small Map	
Land Wall Map	
Tracings	
France Map	
Pierce Map	
Misc.	

County Morton Elev. 3536
 Sec. 10 Twp. 34 Rge. 13W
 Company Panhandle Eastern
 Farm Name Interstate No. 1

TOPS	DEPTH	LOG	DATUM	Loc. in Sec.
Anh. <u>Waub</u>		<u>2578</u>		<u>C NE/11</u>
Tr.		<u>2786</u>		
H.				
Tr.				
Dg.				
Bl.				
L.		<u>303 1/2</u>		Geol.
K.C.				Contr.
B.K.C.				<u>Musgrove</u>
Ce.				Pool
C.				<u>Greenwood</u>
M.				
M.				
K.				
Mz.				
Me.				
V.				
S.				
S.				
A.				
R.				
Pe.				
G.				
T.D.				

Date Comm. 9-10-55 OCT 12 1955

8" @ 592/350 5 1/2" @ 3083/200

24/ 3038-44 2 gwph 1000 A

451 mcfg 15 gwph PB 3005 20/ 2978-83

16/ 2950-54 20/ 2936-41 28/ 2923-30

28/ 2912-19 28/ 2905-12 5000 A

2,354 mcfg 14 hr. SP 2890 28/ 2871-78

28/ 2850-56 28/ 2833-40 24/ 2818-24

938 mcfg 1000 A 9,113 mcfg 13000 A

OVER

OCT 24 1955

Scout Cards	<u>mm^c</u>
1/4rd Small Map
1/4rd Wall Map
Tracings
France Map
Pierce Map
Misc.

CO to 3005 10, 954 mcrg 14 hr BD
Comp, 17, 675 mcrgpd 418#