

Morton


KANSAS

SECTION 10 TOWNSHIP 34 RANGE 41W

WELL NO. #1-10 Baughman

COMPANY P.E.P.L.

NORTH

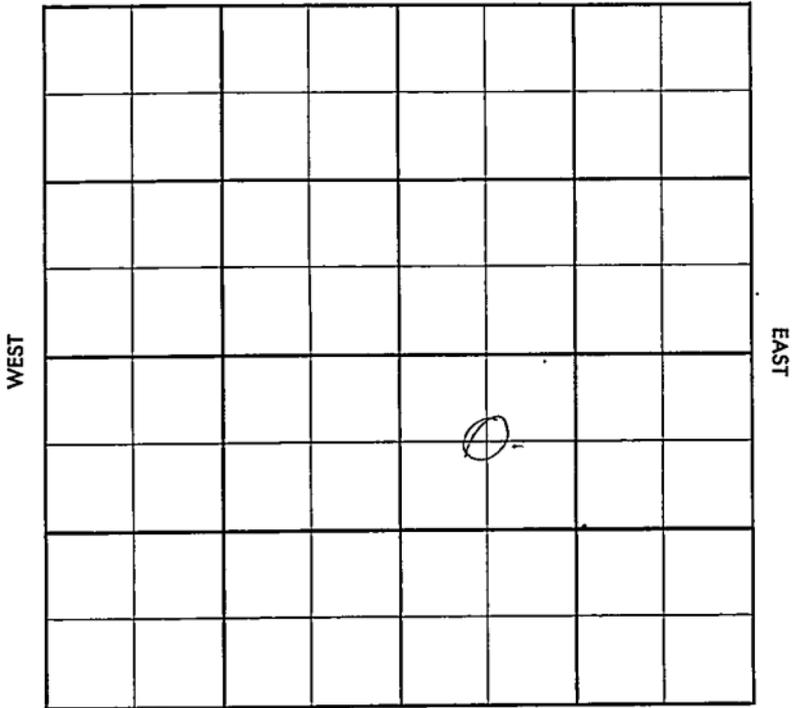

SOUTH

County Morton Elev. _____

Sec. 10 Twp. 34S Rgs. 11W

Company P. E. P. L.

FarmName Baughman No. 1-10

TOPS DEPTH LOG DATUM

Anh.			
TP.			
H.			
Tr.			
Dg.			
Bl.			
L.			
K.C.			
B.K.C.			
Ce.			
C.			
M.			
M.			
K.			
Mz.			
Me.			
V.			
S.			
S.			
A.			
R.			
PE.			
G.			
T.D.			

Loc. in Sec. _____

C NW SE

Geol. _____

Contr. _____

Garvey

Pool _____

Greenwood

FIRST REPORT		
		0
OCT	3	'56

Date Comm. 9-25-56

7" 56 1/2 w/250; D 1640

54

Co.

Lse.

No.

Sec.

T.

R.

FORM 513 SUNRAY

County Morton Elev. 3406
 Sec. 10 Twp. 36S Rge. 1W
 Company D. F. F. L.
 Farm Name McLeman No. 1-10

TOPS	DEPTH	LOG	DATUM	Loc. in Sec.
Anb.				C 1W 24
Tr. <u>Kri</u>		<u>2169</u>		
H. <u>wFd</u>		<u>2230</u>		
Tr. <u>Tou</u>		<u>2287</u>		
Dg.				
Bl.				
L.				
K.C.				Geol.
B.K.C.				Contr.
Ce.				<u>Barney</u>
C.				
M.				
M.				Pool
K.				<u>or wood</u>
Mz.				
Me.				
V.				
S.				
S.				
A.				
R.				
Pe.				
G.				
T.D.	<u>2330</u>			

COMPLETE
 0
 JUL 3 '57

Date Comm. 1-24-56
7" 561 / 1000 ; 11 1610 25110 4 1/2 @
2228/300 2 1/2 CO CO 16/
2262-68 8/ 2271-73 11
9a 671 MCF 13 9a 1.730 MCF
20/ 2230-35 12' 2240-43 40/
2246-56 11 9a 1.939 MCF 40
12170-80 68/ 2186-2203 11 556
13 9a 122 MCF CO 2270 9a
3.500 MCF 2270 OCT 24 '56 OCT 31 '56
 Aug 7 '56 NOV 13 '56 NOV 21 '56 MAR 20 '56

DEC 5 '56 DEC 12 '56 DEC 19 '56 DEC 26 '56 JAN 2 '57

JAN 9 '57 JAN 16 '57 JAN 23 '57 JAN 30 '57 FEB 6 '57

FEB 13 '57 FEB 20 '57 FEB 27 '57 MAR 6 '57 MAR 13 '57 MAR 20 '57

MAR 27 '57 APR 3 '57 APR 10 '57 APR 17 '57 APR 24 '57 MAY 1 '57

MAY 8 '57 MAY 15 '57 MAY 22 '57 MAY 29 '57 JUN 5 '57 JUN 12 '57

JUN 19 '57 JUN 26 '57 JUL 3 '57 *Deliv. 4st*

1. 16 MCFGpd.