


Sumner

KANSAS

SECTION 11 TOWNSHIP 34 RANGE 4 W

WELL NO. #1 Davis

COMPANY Iron Drlg.

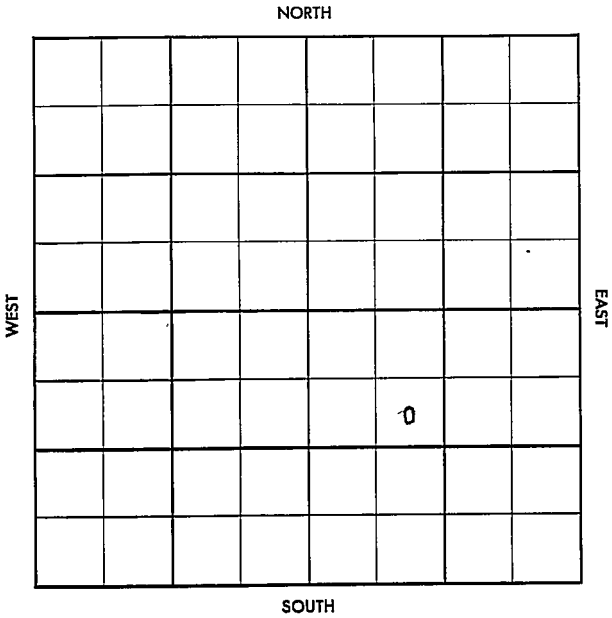

Summer

KANSAS

SEC.	TWP.	R.
11	34	4W

WELL NO.

#1 Davis

FARM

COMPANY

Iron Drlg

CONTRACTOR

R. C. Patton

Wildcat


_____ Ft. from N. Line

_____ Ft. from S. Line

_____ Ft. from E. Line

_____ Ft. from W. Line

SE NW SE

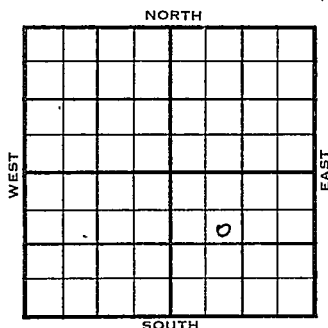

1955

ELEVATION

1182

REPORT

10/19

Comm 10-11-55
Drlg 2665

11/9

Comm 10-11-55
8" @ 276/200

Stal

3224

KC

3555

3551

Line

4278

4278

K

4604

Mz

4667

S

4669

4670

A

4849

TD

4884

DST 4282-98 open 1 hr 500 mcfgpd

rec 85' o & gcm 30' ocmw 1530#

DST 4661-91 open 1 hr rec 1350'

gas 70' G & socw 90' gcw 1880#

D & A

ABANDONED

County Sumner

Elev.

Sec. 11 Twp. 34Rge. 14WCompany Iron Drlg.Farm Name DavisNo. 1

TOPS

DEPTH

LOG

DATUM

Loc. in Sec.

Anb.

SE NW SE

Tp.

H.

Tr.

Dg.

Bl.

L.

K.C.

B.K.C.

Ce.

C.

M.

M.

K.

Mz.

Mq.

V.

S.

S.

A

R.

P.C.

G.

T.D.

Geol.

Contr.

R.C. Patton

Pool

Wildcat

FIRST REPORT
OCT 19 1955

Date Comm. 10-11-55

drlg. 2665

20

County Sumner Elev. 1182
 Sec. 11 Twp. 34 Rge. 4W
 Company Iron Drlg.
 Farm Name Davis No. 1

TOPS	DEPTH	LOG	DATUM
Anh.			
T.P.			
H. <u>stal</u>		<u>.3224</u>	<u>2042</u>
Tr.			
Dg.			
Bl.			
L.			
K.C.	<u>35.55</u>	<u>.35.51</u>	<u>2369</u>
B.K.C.			
Ce.			
C.			
M. <u>lime</u>	<u>4278</u>	<u>4278</u>	<u>.3096</u>
M.			
K.		<u>41004</u>	<u>3422</u>
Mz.		<u>41067</u>	<u>3485</u>
Ma.			
V.			
S.	<u>41069</u>	<u>41070</u>	<u>3488</u>
S.			
A.		<u>4849</u>	<u>.31067</u>
R.			
Pe.			
G.			
T.D.	<u>4884</u>		

Loc. in Sec.

SE NW SE


Geol.

Contr.

R. C. Patton

Pool

Wildcat

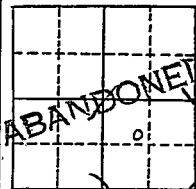

Date Comm. 10-11-55 NOV 9 1955

8" @ 276/200 DST 4282-98 open 1 hr.

500 mcf/gpd rec. 85' o & gcm 30' ocmw

1530# DST 4661-91 open 1 hr.

rec. 1350' gas 70' g & socw 90' gcw

1880#

D & A