
Sumner KANSAS

DX 78-1

Section 11 Township 34 Range 1W

Well No. 1 Dietrich

Company Helmerich & Payne

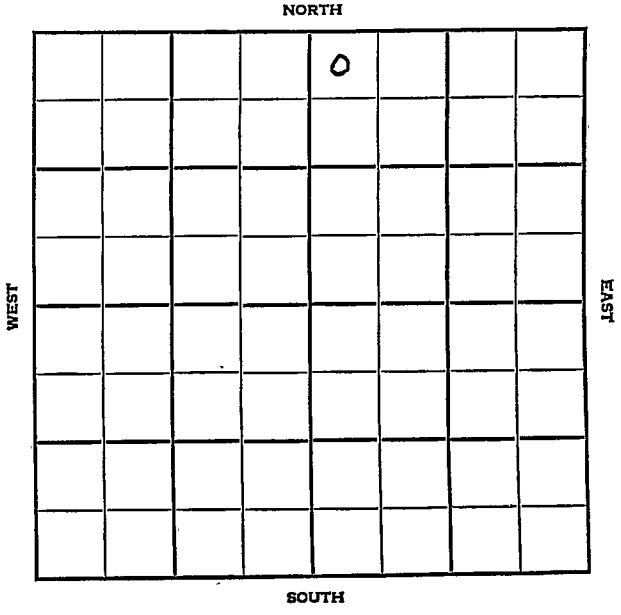

Sumner KANSAS

SEC.	TWP.	R.
11	34	4W

WELL NO. 1 Dietrich FARM

COMPANY Helmerich & Payne

CONTRACTOR Peel Bros

Wildcat


330 Ft. from N. Line

Ft. from S. Line

Ft. from E. Line

330 Ft. from W. Line

NW NW NE

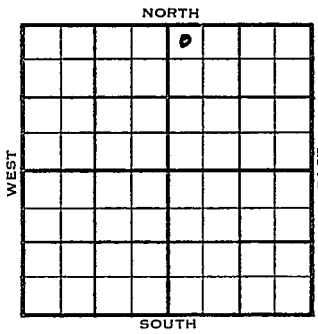

1954	ELEVATION 1209'	REPORT
6/30	Spudding 6-25-54 10" @ 195 Drlg. 1560	
6/30	"	
7/7	" 3720	
7/21	Spud 6-25-54 D&A TD 4782' 10" @ 195' Florence Flint 1255', Tor 1730', Top 2525', Oread 2930', Os wego 3903', KC 3562', Miss 4296', Kh 4635', Meisner 4707', Viola 4711', Simp Dol 4719', Simp. sd 4739' DST 4739-44', opn XX 2 hrs., rec. 325' SW, 1820# DST 4454-80', opn 3 hrs., rec. 913' SW, 1611# TD 4782' D&A	

ABANDONED

DX-78

FORM 275 FOR SALE BY KANSAS BLUE PRINT CO.


County Sumner State Kansas

Sec. 11 (Blk. Twp.) 34 (Sur. Rge.) 4W Map No.

Operator Helmerich & Payne

Well No. 1 Farm Dietrich

Elev. Location NW NW NE

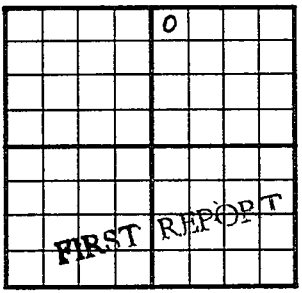

330 Ft. From N Line NE

330 Ft. From W Line Quarter

1st. Report JUN 30 1954

Completion

Remarks

Peel Bros. - Contr.

Spudding Date 6-25-54

Drlg. Data Wildcat

10" @ 195 drlg. 1560

J. G. McGEHEE

FORM 275 FOR SALE BY KANSAS BLUE PRINT CO.


County Sumner State Kansas

Sec. 11 (Blk. Twp.) 34 (Sur. Rge.) 4W Map No.

Operator Helmerich & Payne

Well No. 1 Farm Dietrich

Elev. 1209 Location NW NW NE

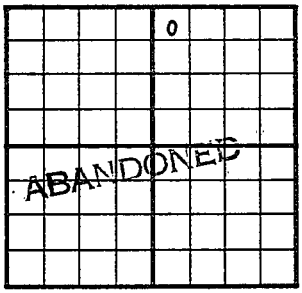

330 Ft. From N Line NE

330 Ft. From W Line Quarter

1st. Report

Completion JUL 21 1954

Remarks Wildcat

Peel Bros - Contr.

Spudding Date 6-25-54

Drlg. Data D & A TD 4782

10" @ 195 Florence flint 1255

Tor. 1730 Top. 2525 Oread 2930

Oswego 3903 KC 3562 Miss. 4296

Kh. 4635 Meisner 4707 Viola 4711

Simp. dol. 4719 Simp. sd. 4739

DST 4739-44 open 2 hr. Rec. 325' sw

1820# DST 4454-80 open 3 hr.

Rec. 913' sw 1611# TD 4782

D & A

J. G. McGEHEE