


DX 78-1

Section 11 Township 34 Range 11W  
Well No. 1 Koontz  
Company Rupp- Ferguson

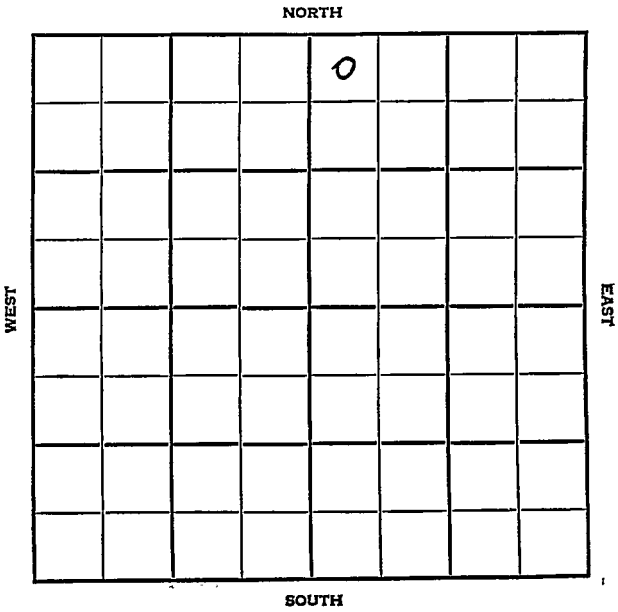

**NOT FILE**

Barber KANSAS

SECT.	11	34	R.	11 W
-------	----	----	----	------

WELL NO.

# 1 Koontz

FARM

COMPANY

Rupp-Ferguson

CONTRACTOR

Co tools

Wildcat

330


Ft. from N. Line

Ft. from S. Line

Ft. from E. Line

330

Ft. from W. Line

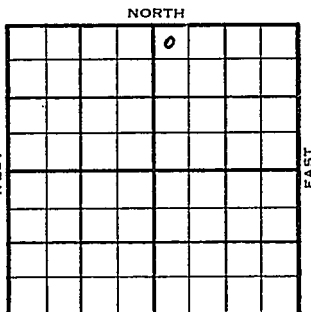

NW NW NE  
 MCPC has NW $\frac{1}{4}$  & E $\frac{1}{2}$  SW $\frac{1}{4}$   
 of 14.

1954	ELEVATION	REPORT
	1406'	

7/21 Spud 7-21-54  
 8" @ 221 broke loose. Pulled.  
 10" @ 252. Drlg. 3240'

7/29 Elgin 3503' Doug. 3702' KC 4150'  
 Miss. 4576'  
 DST 4578-98, open 1 hr gas in 11 min,  
 rec 45' mud. 1480#  
 DST 4597-4647' (Ltr-McGehee)

8/11 TD 5214' 5" @ 4761'  
 8/25 Spud 7-12-54 D & A TD 5214  
 10" @ 252 Elgin 3503 Doug. 3702  
 KC 4150 Miss 4576  
 DST 4578-98 open 1 hr gas in 11 min  
 rec 45' mud 1480#  
 DST 4597-4640 open 2 hr rec 220'  
 So & GCM, 220' OCM, 220' VHO CM  
 360' @ & GCSW 1740# Kh. 4744  
 Chat 4847 Misener 4873 Viola 4880  
 Simp. 4979  
 DST 4980-5008 open 2 hr rec 3192' SW  
 1870# Arb. 5176#  
 TD 5214 5" @ 4761 GO to 4725  
 33/4606-14 B/28' fluid 35% oil 65%  
 water. Sd-frac, rec wtr. PB 4590  
 33/4580-88 B/12' fluid 10% hvy blk  
 oil, 90% wtr. Sd-frac. S/5% 10 BWP  
 D & A

**ABANDONED**



