DX 78-1


Meade

KANSAS

Section 11 Township 34 Range 29W

Well No. #1 Adams Ranch "A"

Company Lario Oil & Gas

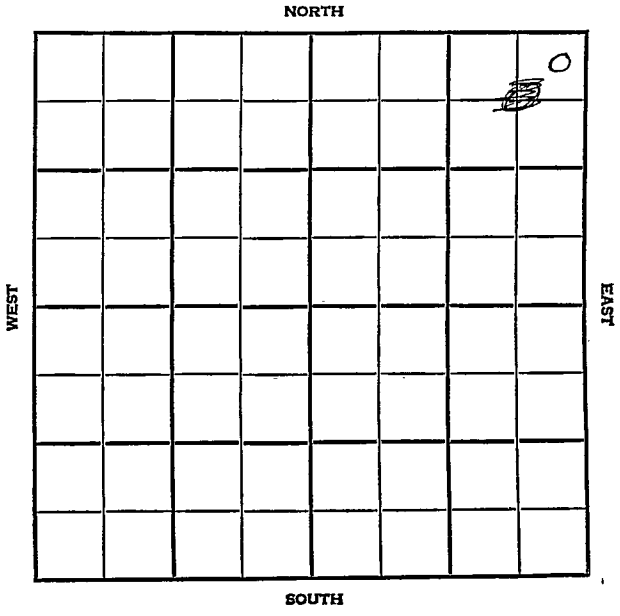

FORM 513 SUNRAY

County Meade Elev.

Sec. 11 Twp. 34 Rge. 29W

Company Lario Oil & Gas

Farm Name Adams Ranch "A" No. 1

TOPS	DEPTH	LOG	DATUM
Anh.			
T.P.			
H.			
Tr.			
Dg.			
Bl.			
L.			
K.C.			
B.K.C.			
Ce.			
C.			
M.			
M.			
K.			
Mz.			
Mq.			
V.			
S.			
S.			
A			
R.			
P€			
G.			
T.D.	6100		

Loc. in Sec. NE NE NE

Geol.

Contr. Sterling Drlg

Pool

NOV 7 '56

FIRST REPORT

Date Comm. Spd. 11-8-56 Texas (FO)

Co. Lse. No. Sec. T. R.

FORM 513 SUNRAY

County Meade Elev. 2433

Sec. 11 Twp. 34 Rge. 29W

Company Lario Oil & Gas

Farm Name Adams Ranch "A" No. 1

TOPS	DEPTH	LOG	DATUM
Anh.			
Fp.			
H. Chase grp	2627	2591	
Tr. Ft Riley	2837		
Dg. Cn grp	3155		
Bl. Tr	4381		
L.	4451		
K.C.			
B.K.C.			
Ce. Marm	5147	5137	
C. ce	5358		
M. Mursh	5662	5664	-3231
M. Mus Li	5674		
K. " sd	5717-23	5718	
Mz. Chest	5760	5760	-3327
Mo.			
V.			
S.			
S.			
A			
R.			
PE.			
G.			
TD. 5860	~~5150~~	5861	

Loc. in Sec. NE NE NE

~~Sw~~ E

~~SE~~ & NE M

Geol. NW 12

Contr. Sterling Drlg

Pool Horace NE

MAR 13 '57

ABANDONED

Date Comm. NOV 13 '56 Spd. 11-8-56 Texas (FQ)

11-16-56 8 5/8 @ 1489/1000 woc NOV 21 '56

@ 3175 NOV 28 '56 @ 4980 DEC 5 '56 X

DST 5208-24 1hr G/6" TSTM

rec 20' Md + 270' VHOCM (25% oil)

+ 270' Free oil + 180' SW FP 65-

260 BHP 1155/25" ~~@ 5513~~ DST

5627-46 1hr rec 55' Md BHP 32/25"

DST 5704-22 90" 44' Md BHP 890/30"

ard DEC 12 '56

FORM 513-1 SUNRAY

crd 5722-50 rec 16' (550 in 14') DST 5720-50 1hr. rec 160' 50% GCM FP 58-95 BHP 420/30" DST 5796-5820 1hr 90' MD BHP 350/30" 5½ @ 5814/250 DEC 19 '56 co 5790 64/5723-39 ½ B ½ GO + 2 GWph 3 hrs Frac 20 x 20 DEC 26 '56 ga 857 MCFG S.I. 72 hrs ga 734 MCFG (wet) SIP 1425 JAN 2 '57 PB 5252 12/5217-20 N/A 8' 5½ BFph 6 hrs 50% wtr POP. JAN 9 '57 JAN 13 '57 P. 35.7 BO + 1.03 BW in 23 hrs P. 25 BO + 35 BW in 24 hrs JAN 23 '57 P. 15 BO + 36 BW 24 hrs JAN 30 '57 P. 13 BO + 31 BW 24 hrs FEB 6 '57 Decl. 6.84 BO + 33.06 BW in 24 hrs FEB 13 '57 FEB 20 '57 FEB 27 '57 P. 5 BO + 33 BW 24 hrs. MAR 6 '57 MAR 13 '57

D & A

11-34-29 ne ne ne