


Section 11 Township 34 Range 34-W

Well No. #1 Adamson

Company Cabot Carbon

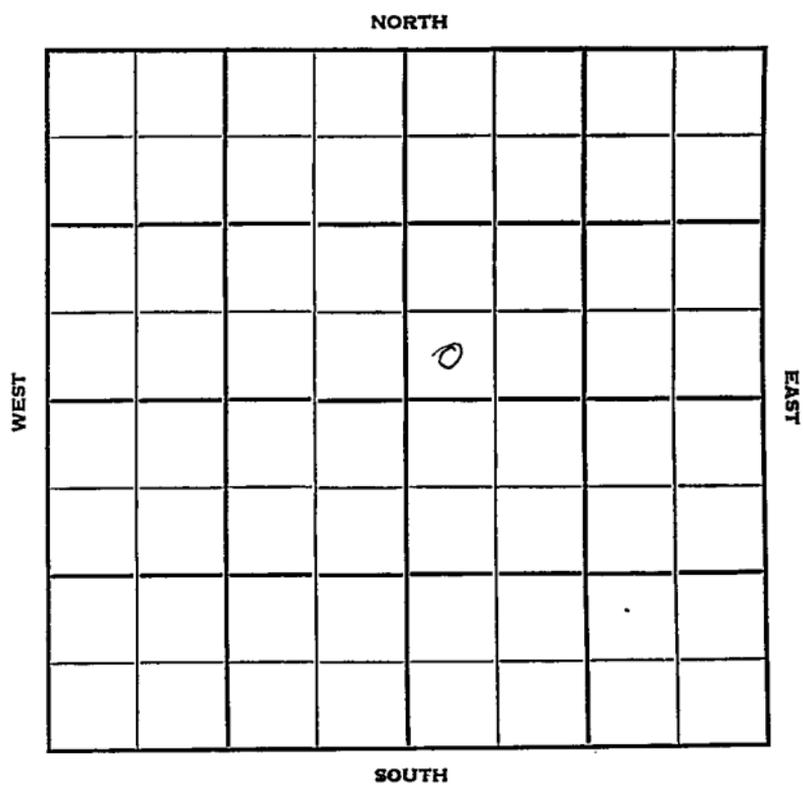

KANSAS
34

Seward
34-W

Sec. 11 Twp. _____ R. _____

Well No. #1 Adamson Farm

Cabot Carbon Company

Contractor

Hugoton


_____ Ft. from N. Line

330 Ft. from S. Line

_____ Ft. from E. Line

330 Ft. from W. Line

SW SW NE

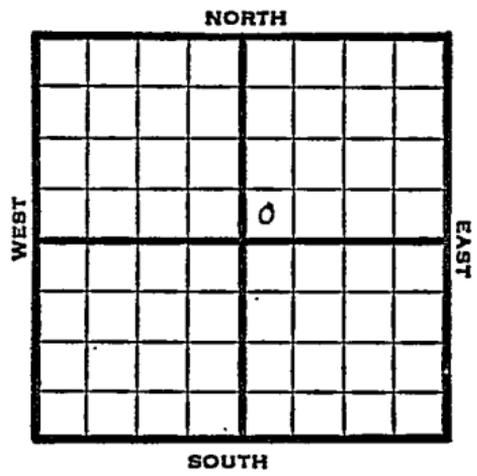

1950 Elev 2901 REPORT

10/11 Location
 12/6 Spud 10-2-50
 10" @ 679
 7" @ 2623
 TD 2731
 Her 2619
 13500 A
 Comp 17,792,000 gas
 Completed
COMPLETED

County Seward State Kansas

Sec. 11 (Blk. Twp.) 34 (Sur. Rge.) 34W Map No.

Operator Cabot Carbon

Well No. 1 Farm Adamson

Elev. 2901 Location SW SW NE

330 Ft. From S Line NE

530 Ft. From W Line Quarter

1st. Report OCT 11 1950

Completion _____

Remarks _____

Spudding Date _____

Drlg. Data Hugoton Pool

Location _____

Scout Cards
Land Small Map
Land Wall Map
Tracings
France Map
Pines Map
Misc.

70

3

OCT 17 1950

Orig. Data

County Seward State Kansas

Sec. 11 (Blk. 1 Twp.) 34 (Sur. 34W Rge.) Map No.

Operator Cabot Carbon

Well No. 1 Farm Adamson

Elev. 2901 Location SW SW NE

330 Ft. From S Line NE

330 Ft. From W Line Quarter

Ist. Report

Completion DEC 6 1950

Remarks Hugoton Pool

Spudding Date 10-2-50

Drlg. Data Gas well TD 2731

10" C 679 7" C 2623 TD 2731 Her. 2619

13500 A Comp. 17,792,000 gas

J. E. TYRA

DEC 12 1950

FW

12

Scout Cards

Land Sr 3

Land Sr. 1 Map

Tracings

French Map

Pierce Map

Misc.

Orig. Data