

KANSAS

Stevens

Section 11 Township 34 Range 35WWell No. 1 RittenoureCompany Texas
Hugoton

NORTH

WEST

			6				

EAST

SOUTH

Stevens

KANS

Sec. 11 Twp. 34 R. 35W

Well No. #1 Rittenoure Farm

Texas

Company

Hugotnn Pool

 Ft. from N. Line

150'


 Ft. from S. Line

150'

 Ft. from E. Line

 Ft. from W. Line

SE NW

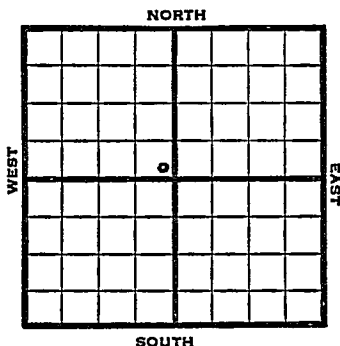

1949 Elev. 2984 DF REPORT

9/21 10" @ 720'
Drlg. 1845'

9/28 TD 2790
7" @ 2789'

10/ 5 "

10/12 396 shots 2704-
2000 acid

10/19 96 shots 2644-60
13000 acid

10/26 7" @ 2789'
Perf
Acid 20,000
Gas 24,687,000
R Pr. 399#
TD 2790'

COMPLETED

Map No. _____ Sec. 11 Twp. 34 R. 35W

Well No. 1 Rittenoure

Texas

Company

Contractor

SE NW

FIRST REPORT
SECTION PLAT

_____ Ft. from N. Line

150 Ft. from S. Line

150 Ft. from E. Line

_____ Ft. from W. Line

Stevens County

Location _____

Rig up _____

Drilling and Remarks:

10" @ 720

drlg. 1845

RECORD

Cased _____ in., _____ ft.

Sand _____

Gas _____

Oil _____

Total Depth _____

PRODUCTION

1st 24 hrs. Nat. _____

1st 24 hrs. after shot _____

Gas _____ Cu. Ft.

Dry Hole _____

Abandoned _____

Date

SEP 21 1949 19

S. J. LEWIS Scout

Kansas

Hugoton Pool

Map No. _____ Sec. 11 Twp. 34 R. 35WWell No. 1 Rittenoure

Texas

Company _____

COMPLETE

Contractor _____

SE NW

E/ 2884
SECTION PLAT

	0		

_____ Ft. from N. Line

150

_____ Ft. from S. Line

150

_____ Ft. from E. Line

_____ Ft. from W. Line

Stevens County

Location _____

Rig up _____

Drilling and Remarks:

*7" C2789**Perf.**20000 acid**24,687,000 Gal**200 * R/R*

RECORD

Cased _____ in., _____ ft.

Sand _____

Gas _____

Oil _____

Total Depth 2790

PRODUCTION

1st 24 hrs. Nat. _____

1st 24 hrs. after shot _____

Gas _____ Cu. Ft.

Dry Hole _____

Abandoned _____

Date

OCT 26 1949

19

S. J. LEWIS

Scout