


Section 11 Township 34 Range 36NWell No. #1. WheelerCompany Republic Natural Gas

KANSAS

Stevens County

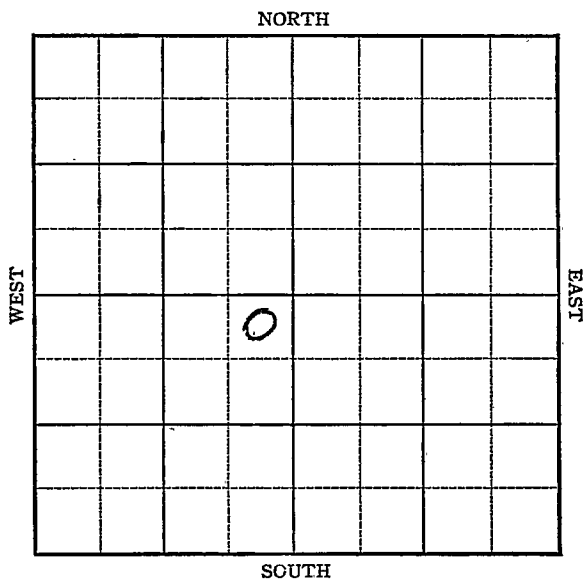

Sec. 11 Twp. 34 R. 36W

Well No. #1 Wheeler Farm

Republic Natural Gas Company

Hugoton


300 Ft. from N. Line

 Ft. from S. Line

300 Ft. from E. Line

 Ft. from W. Line

NE SW

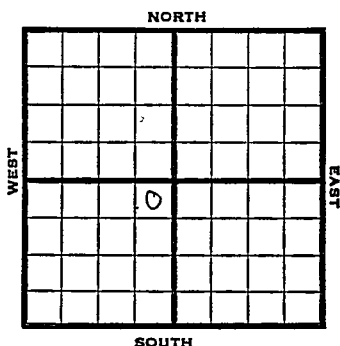

1946 Elev. 3043 REPORT

4/3 600'

4/19 10" @ 731
TD 2660-
7" @ 2650 RUST

4/16 TD 2777

4/23 TD 2799
175' of 5" liner @ 2799
12500 acid

5/7 " " "

5/15 7" @ 2650'
175' of 5" perf. liner @ 2799
TD 2799'
12,500 acid.
16,667,000 Gas
409# R Pr.

COMPLETED

KANSAS Kansas Pool Name Hugoton
 Map No. now Sec. 11 Twp. 34 R. 36W
 Well No. 1 Wheeler

Republic Natural Gas

Company

FIRST REPORT

Contractor

NE SW


SECTION PLAT

300 Ft. from N. Line

Ft. from S. Line

300 Ft. from E. Line

Ft. from W. Line

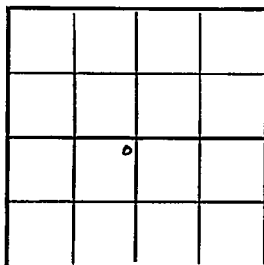

Stevens County

Location

Rig up

Drilling and Remarks:

600'

RECORD

Cased 12 in. 12 ft.

Sand

Gas

Oil

Total Depth

PRODUCTION

1st 24 hrs. Nat.

1st 24 hrs. after shot

Gas 1 Cu. Ft.

Dry Hole

Abandoned

Date

APR 3 1946

19

S. J. LEWIS Scout

~~KANSAS~~

Kansas

Pool Name Hugoton PoolMap No. 1 Sec. 11 Twp. 34 R. 36WWell No. 1 Wheeler

Republic Natural Gas

Company


COMPLETED

Contractor

NE SW

E1,3043

SECTION FLAT

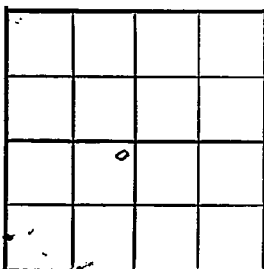300 Ft. from N. Line Ft. from S. Line300 Ft. from E. Line Ft. from W. Line

Stevens County

Location Rig up

Drilling and Remarks:

7" @ 2650175' x 5" Tee / kneeC279912500 Acid16,667,000 Gals408 #12 PE**RECORD**Cased in., ft.Sand Gas Oil Total Depth 2798**PRODUCTION**1st 24 hrs. Nat. 1st 24 hrs. after shot Gas Cu. Ft.Dry Hole Abandoned

Date

MAY 15 1946

19

S. J. LEWIS

Scout