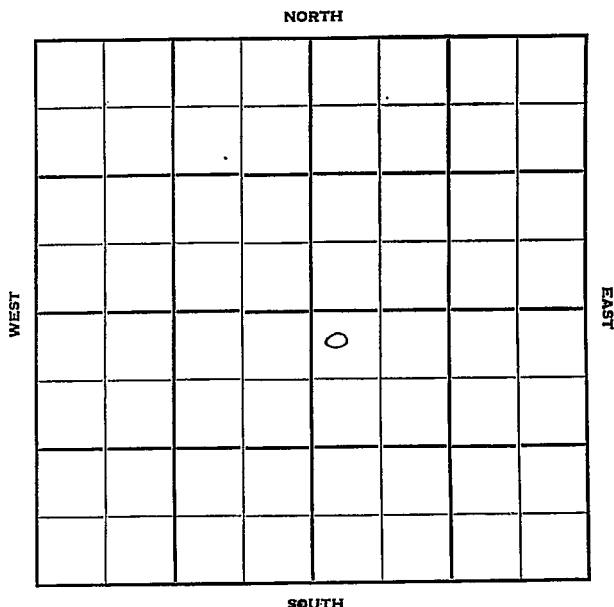


Section 11 Township 34 Range 41WWell No. #1 Eagley (A)Company Cities Service Oil

Morton

KANSAS

Sec. 11

Twp. 34

R. 41W

Well No. #1 Eagley (A) Farm

Cities Service Oil Company

Barbour - Contr. Contractor

Hugoton


225' Ft. from N. Line

Ft. from S. Line

Ft. from E. Line

225' Ft. from W. Line

NW NW SE

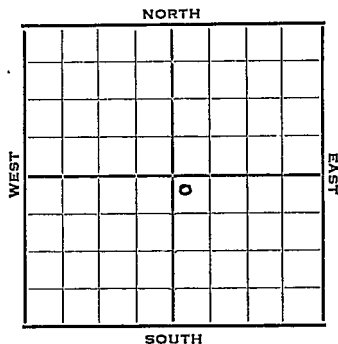

1952

Elev. 3385' REPORT

1/30

MIR

2/6

TD 2340 5" @ 2339

2/13

CO to 2321 30/ 2314-20
30/ 2284-90 30/ 2300-2306
5000 A 200' wtr set retainer,
sq. off CO to 2272 110/ 2238-60
50/ 2222-32 Her 2186 Up Krider 2221
Lo Krider 2236 Winfield 2280

2/20

Total of 13,750 A

3/5

NR

3/12

Spud 1-29-52

Gas well TD 2340' 8" @ 304
5" @ 2339' TD 2340' CO to 2321'
30/2314-20 30/2284-90 30/2300-2306
5000 A 200' water CO to 2272'
110/2238-60 50/2222-32' Her 2186'
Kri 2221' Win 2280' 13,750 A
Comp. 2,740,000 gas

COMPLETED







FIRST REPORT

225 Ft. From N Line SE

225 Ft. From ~~W~~ Line Quarter

1st. Report JAN 3 0 1952

Completion

Remarks

Barbour - Contr.

Spudding Date

Drlg. Data

Hugoton

1672


J. G. McGEHEE

County Morton State
 Sec. 11 (Blk.) 34 (Sur.) 41W Map No.
 (Twp.)

Operator Cities Service

Well No. 1 Farm Eagley "A"

Elev. 3385 Location NW NW SE

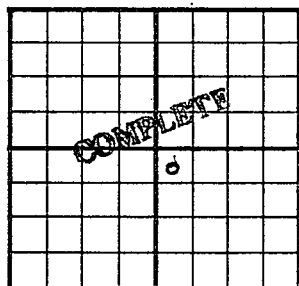

225 Ft. From N Line SE

225 Ft. From W Line Quarter

1st. Report

Completion MAP 1 7 1952

Remarks Hugoton Pool
Barbour - Contr.

Spudding Date 1-29-52

Drlg. Data Gas well TD 2340

8" @ 304 5" @ 2339 TD 2340 CO to 2321

30/ 2314-20 30/ 2284-90 30/ 2300-2306

5000 A 200' water CO to 2272

110/ 2238-60 50/ 2222-32 Her. 2186

Kri. 2221 Win. 2280 13750 A

Comp. 2,740,000 gas