


Stevens
Form 51-5M-2-29-34703

Map No. **KANSAS** Sec. 11 Twp. 34 R. 38W

Well No. 1- Greenwood Farm
Western Production Company

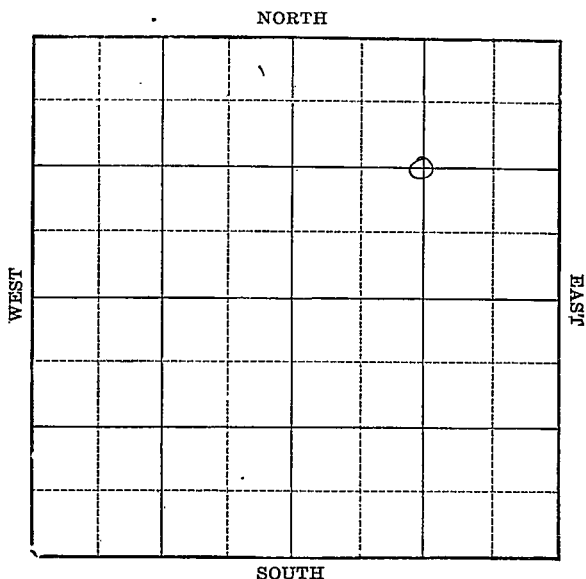

Location _____
Drilling Remarks _____

Rig Up _____
Drilling Remarks _____

RECORD

Cased _____ in. _____ ft.
Sand _____
Gas _____
Oil _____
Total Depth _____

PRODUCTION

1st 24 hrs. Nat. _____
1st 24 hrs. after shot _____
Gas _____ cu. ft. _____
Dry Hole _____
Abandoned _____

Map No. KANSAS Sec. 11 Twp. 34 R. 38^w
Well No. 1- Greenwood Farm
Western Prod Co Company


NORTH

1320 Ft. from N. Line

_____ Ft. from S. Line

1320 Ft. from E. Line

1931 Ft. from W. Line

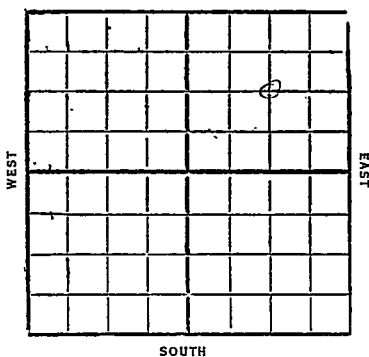

Date

REPORT

3/25	Loc
4/18	
4/15	Bl. d. g. rig
4/22	Rig up
4/29	drilg 950'
5/6	" 1500'
5/13	T.D. 2582' Rust
5/20	
5/27	T.D. 2820
	6 M Gas
	Comp.

Stevens
 Map No. **KANSAS** Sec. 11 Twp. 34 R. 38W

Well No. 1 Greenwood

Western Production Company

Contractor


SECTION PLAT

1820 Ft. from N. Line

0 Ft. from S. Line

1320 Ft. from E. Line

0 Ft. from W. Line

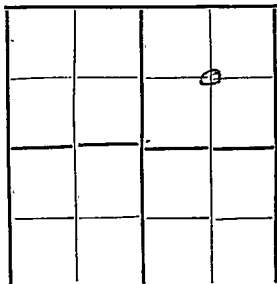

* FIRST REPORTS

Location *✓*

Rig up

Drilling and Remarks:

RECORD

Cased 1/2 in., 0 ft.

Sand

Gas

Oil

Total Depth

PRODUCTION

1st 24 hrs. Nat.

1st 24 hrs. after shot

Gas 0 Cu. Ft.

Dry Hole

Abandoned

Date

MAR 25 1931⁹² S. I. LEWIS Scout

no wall
no small

Returned	
Cards	<i>[initials]</i>
Tracing	X
France Map	X
Scarborough Map	X
Moody Map	X
Scarborough Plat Book	
Moody Plat Book	

*Stevens*Map No. **KANSAS** Sec. *11* Twp. *34* R. *38* ^WWell No. *1* *Greenwood**Western Production* Company

Contractor

COMPLETED


SECTION PLAT

1380 Ft. from N. Line

Ft. from S. Line

1380 Ft. from E. Line

Ft. from W. Line

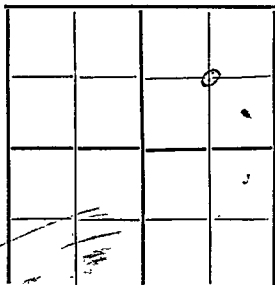

Location

Rig up

Drilling and Remarks:

RECORD

Cased _____ in., _____ ft.

Sand _____

Gas _____

Oil _____

Total Depth *7870*

PRODUCTION

1st 24 hrs. Nat. _____

1st 24 hrs. after shot _____

Gas *6 M* Cu. Ft.

Dry Hole _____

Abandoned _____

Date

MAY 27 1931

192

CHAS. L. SHERWOOD

Scout

Returned

Cards

Tracing

France Map

Scarborough Map

Moody Map

Scarborough Fair Book

Moody Fair Book