

Morton

KANSAS

Section 11 Township 34 Range 40WWell No. #1 FoutsCompany Panhandle Eastern

NORTH

WEST

EAST

				0			

SOUTH

Morton

KANSAS

Sec. 11 Twp. 34 R. 40W

Well No. #1 Fouts Farm

Panhandle Eastern Company

Kuhn Drlg. - Contr. Contractor

1900' Hugoton Pool

Ft. from N. Line


Ft. from S. Line

2486'

Ft. from E. Line

Ft. from W. Line

SW NE

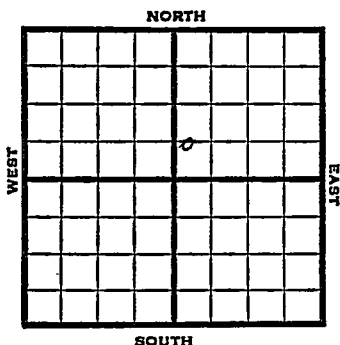

1951

Elev. 3328' REPORT

3/7

Spud 3-4-51

10" @ 506'

WOC

5/9

Spud 3-4-51

Gas Well TD 2664

10" @ 506 7" @ 2450

TD 2664

Hol. 2414 Her 2454 Krider 2480


Win 2540 Ft. Riley 2618

16,000 A Comp. 13,871,000 gas

358#

COMPLETED

J. E. TYRA

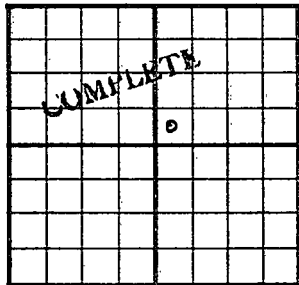County Morton State KansasSec. 11 (Blk.) 34 (Sur.) 40W Map No.Operator Panhandle EasternWell No. 1 Farm FoutsElev. 3328 Location SW NE1900 Ft. From N Line NE2486 Ft. From E Line Quarter1st. ReportCompletion MAY 9 1951Remarks Hugoton PoolKuhn Drlg. - Contr.Spudding Date 3-4-51Drlg. Data Gas well TD 266410" @ 506 7" @ 2450 TD 2664Hol. 2414 Her. 2454 Krider 2480Win. 2540 Ft. Riley 2618 16000 AComp. 13,871,000 gas 358#

J. E. TYRA