WELL LOG BUREAU—KANSAS GEOLOGICAL SOCIETY
508 East Murdock, Wichita, Kansas


12-34-12W

Company- JONES-GEBERT OIL CO
Farm- Zimmerman No. 1

SEC. 12 T. 34 R. 12W
C NE NE

Total Depth. 4930'
Comm. 5-3-63 Comp. 5-15-63
Shot or Treated.
Contractor.
Issued. 8-24-63

County Barber
KANSAS

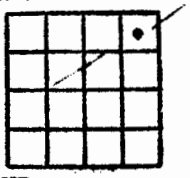

Elevation. 1512' KB

Production. Dry


CASING:
8 5/8" 222' cem w/150 sx.

Figures Indicate Bottom of Formations.

redbed	650
shale & shells	1475
shale & lime	1575
lime & shale	1695
lime	2065
lime & shale	2380
shale & lime	3165
lime & shale	3430
shale & lime	3690
shale & sand	3810
sand & lime	3850
shale & lime	4105
lime	4501
lime & shale	4575
lime	4833
lime & shale	4885
lime	4930
Total Depth	

TOPS:	LOG
Elgin Sand	3609
Heebner	3750
Toronto	3769
Douglas	3784
Douglas Sand	3796
Lansing	3954
Base Kansas City	4166
Marmaton	4254
Mississippi	4642
Kinderhook	4900

12-34-12W

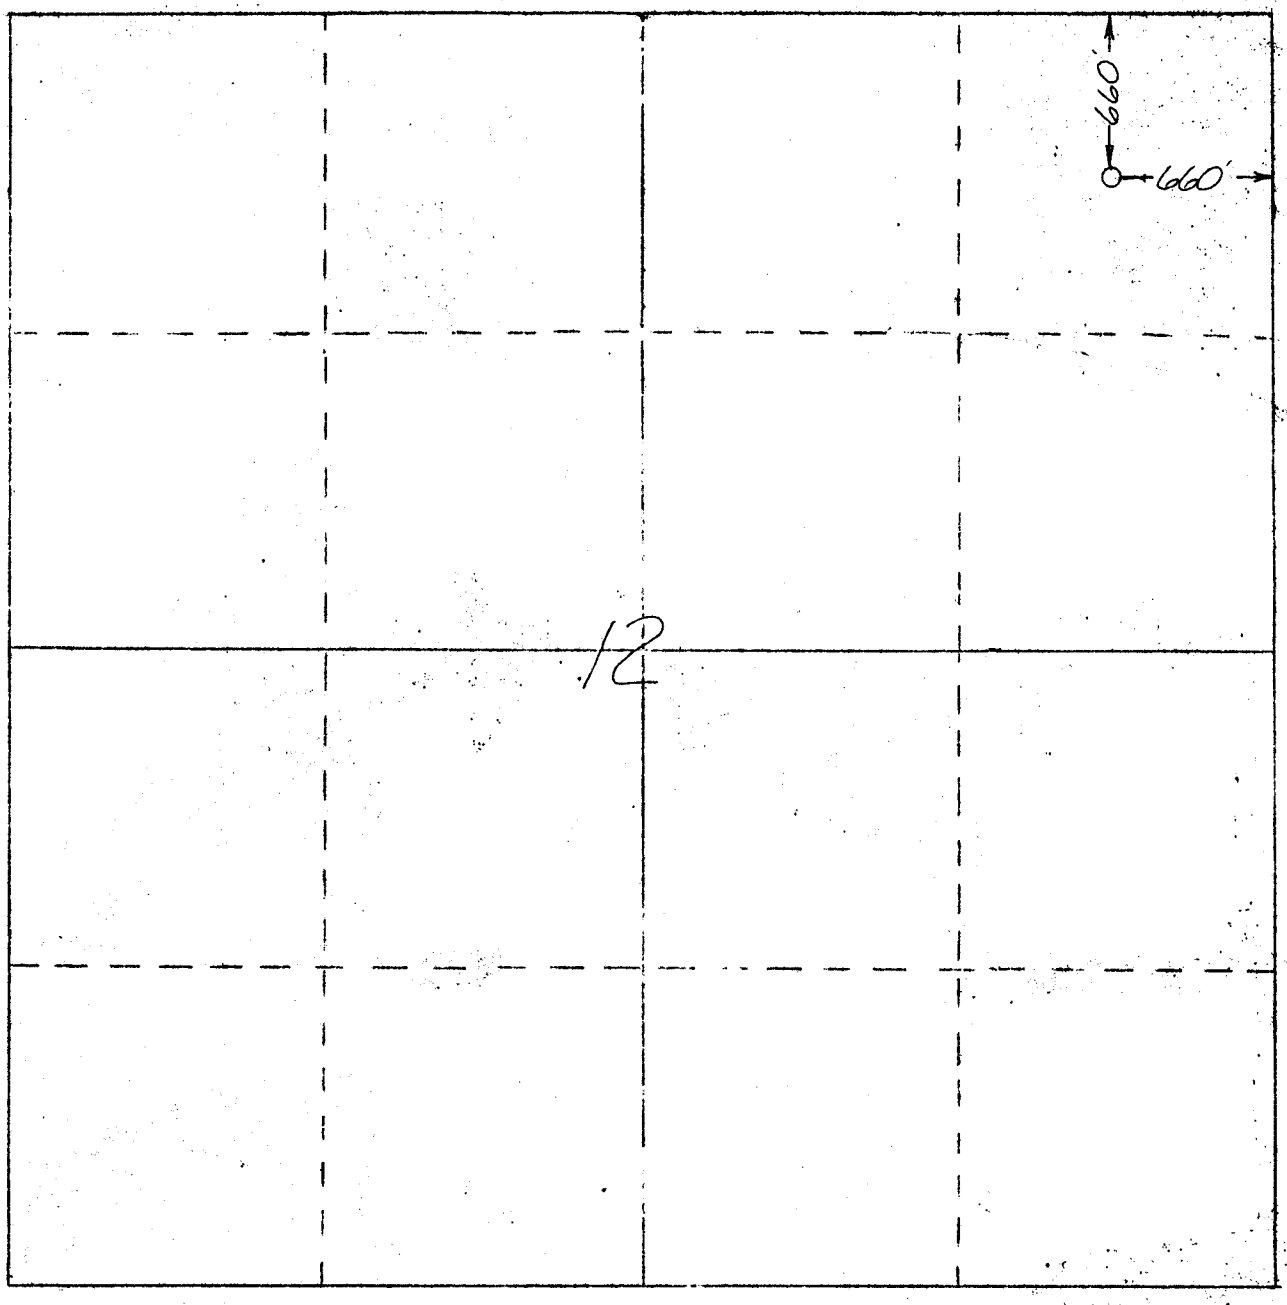

LOCATION in the center of the NE¼ of the NE¼ of Section 12, Township 34S, Range 12W of the 6th P.M.

STAKED BY LEROY E WILLIS
COUNTY ENGINEER

DATE STAKED April 16, 1963
6:00 AM

STAKED FOR Jones Gebert Oil Co.
Central Building
Wichita 2, Kansas