

Barber


KANSAS

SECTION 12 TOWNSHIP 34 RANGE 13 W

WELL NO. # 1 V. L. Cook "B"

COMPANY Atlantic Ref.

NORTH

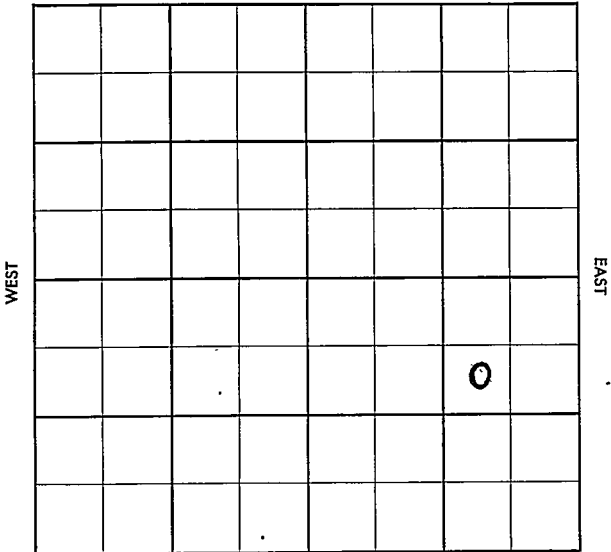

SOUTH

SEC.	TWP.	R.
12	34	13W

WELL NO. #1 V.L. Cook "B" FARM COMPANY

Atlantic Red.

CONTRACTOR

Iron Drlg.


900 Driftwood NORTH
Ft. from N. Line

	Ft. from S. Line	<table border="1" style="display: inline-table; width: 80px;"><tr><td></td><td></td><td></td><td></td><td></td><td></td><td></td></tr><tr><td></td><td></td><td></td><td></td><td></td><td></td><td></td></tr></table>														

Ft. from E. Line

[illegible]

SW NE SE

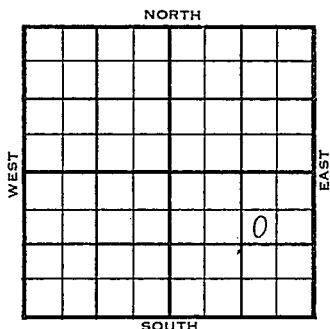

1956	ELEVATION 1599'	REPORT
------	--------------------	--------

4-18 Comm. 4-16-56
8" @ 252 w/260
WOC

7-25 BST 4755-85 op 1 hr. rec. 12' mud,
BHP 45/30".
DST 4765-4840 op 1½ hrs., gas in 6 mi
stabil @ 652 MCF in 75 min. rec. 600'
HGC&VSWCM, BHP 1620/20".
DST 4839-93 op 51 min. gas in 1½ min.
ga. 3.500 MCF in 10", 6.730 in 30 min
Stab. @ 5.690 M. 5/8" chk., rec. 100'
VHGC&SWCM, BHP 1750/30".
5½" @ 4912/300
CO 128/4835-67
ga. 1.730 MCF. ½" chk.
Inc. to 3.310 MCF
Frac; ga 400 MCF, 20/64" chk.
TP 1120#, CP 380#;
ga 6.700 MCF, 28/64" chk., TP 1250#.
CP 1560#
Tst 2.3 boph, 43.1 Grav.
/ 8.45 mcf/gpd,
Est. op flw 28.700 mcf/g. TP 1030#.
CP 1500#.
Elg. Zn. 3664'; H. 3901'; Dg. 3990';
L. 4115'; KC. 4360'; Ce. 4762';
M. Chert 4779'; M. Dolo 4785';
TD 4913'

County Barber Elev. _____
 Sec. 12 Twp. 3N Rge. 13W
 Company Atlantic Ref.
 Farm Name V. L. Cook "B" No. 1

TOPS	DEPTH	LOG	DATUM	Loc. in Sec.
Anb.				SW NE SE
Tp.				900' NL
H.				
Tr.				
Dg.				
Bl.				
L.				Geol.
K.C.				Contr.
B.K.C.				Iron Drlg.
Ce.				
C.				Pool
M.				Driftwood
M.				
K.				
Mz.				
Me.				
V.				
S.				
S.				
A.				
R.				
Pe.				
G.				
T.D.				

FIRST REPORT			
APR 18 1956			

Date Comm. 4-16-56
8" @ 252/260 WOC

APR 18 1956

County Barber Elev. 1599
 Sec. 12 Twp. 31 Rge. 73W
 Company Atlantic Ref.
 Farm Name V. L. Cook ID# 1 No. 7

TOPS	DEPTH	LOG	DATUM	Loc in Sec.
Ann. <u>E1920</u>	<u>3664</u>			<u>SUNSE</u>
Tr.				
H.	<u>3901</u>			<u>200' IN</u>
Tr.				
Dg.	<u>3990</u>			
BL				
L.	<u>4115</u>			Geol.
K.C.	<u>4360</u>			Contr.
B.K.C.				
Ce.	<u>4762</u>			<u>Iron rly.</u>
C.				
M. <u>chert</u>	<u>4779</u>			Pool
M. <u>Dolo</u>	<u>4785</u>			<u>gritwood</u>
K.				
Mz.				
Me.				
V.				
S.				
S.				
A.				
R.				
PE.				
G.				
ID.	<u>4913</u>			

COMPLETE

JUL 25 1956

Date Comm. 1-7-56CH 252/260 APR 25 '56 3250MAY 2 '56 4514 MAY 9 '56

DST 4755-85 1hr see 12' Md
BHP 45/30" DST 4765-4840
1 1/2 hrs 9 in 6" stabil @ 652
MCF in 75" see 600' HGC'S VS
WCM BHP 1620/20" DST 4839-93
or 51" 9 in 1 1/2" ga 3,500 MCF in
10" 6,730 in 30" stab. @ 5,620 M

5/8" ch rec 100' VHGCF SWCM

BHP 1750/30" MAY 16 '56 5 1/2 @

4912/300 4/4800 50d

CO 128/4835-67 $\nearrow$ 9a

1,730 MCF 1/2" ch. inc. to

3,310 MCF MAY 23 '56 Fraq 9a

400 MCF 20/64" ch TP 1120

CP 380 9a 6,700 MCF 28/64"

ch TP 1250 CP 1560# MAY 29 '56

~~EST~~ ~~SP~~ ~~F/100~~, JUN 6 '56 KP+L,

165,000,000 CF, all at 152,000,000

JUN 13 '56 — JUN 20 '56 JUN 27 '56 JUL 3 '56

+st 2.3 Boph 43.1' gran

+ P. 45 MCEGPD JUL 11 '56 EST

op FLW 28,700 MCF TP

1030 CP 1500 JUL 18 '56 JUL 25 '56

complete