

Barber

KANSAS

SECTION 12 TOWNSHIP 34 RANGE 13 W

WELL NO. #1 M. C. Donovan

COMPANY Skelly Oil

NORTH

		0					

WEST

EAST

SOUTH

SEC. 12	TWP. 34	R. 13W
------------	------------	-----------

WELL NO.

#1 M.C. Donovan

FARM

COMPANY

Skelly Oil

CONTRACTOR

Hulme Drlg.

Driftwood


\_\_\_\_\_ Ft. from N. Line

\_\_\_\_\_ Ft. from S. Line

\_\_\_\_\_ Ft. from E. Line

\_\_\_\_\_ Ft. from W. Line

SW NE NW

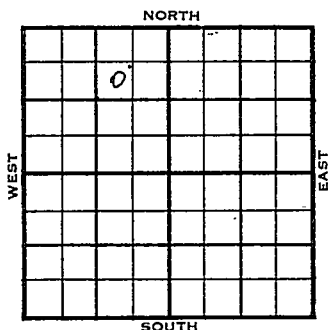

1956

ELEVATION

1562

REPORT

2-29

Loc.

4-11

Comm. 3-4556

8 5/8" @ 272/225

DST 4668-4710 op 1 hr. gas in 3 min.

5720 mcfg, rec. 70' drlg. mud, 1643#

DST 4700-40 op 55 min. gas in 2 min.

5750 mcfg rec. 3' gcm, 1665#

5 1/2" @ 4775 w/150

CO to 4747, 161/ 4704-32, 1 mcfg,

F/ 1450 mcfg, 500 A, frac

F/ 4450 mcfg, ##

PB 4692, 141/ 4666-92

F/ 362 mcfg, 500 A, frac

F/ 4350 mcfg

Comp. open flow 45,247 mcfgpd

H. 3815

L. 4010

BKC 4539


Marm 4552

M. 4664

TD 4775

**COMPLETED**

County Barber Elev. \_\_\_\_\_  
 Sec. 12 <sup>Trp.</sup> 34 Rge. 13W  
 Company Skelly Oil  
 FarmName M. C. Donovan No. 1

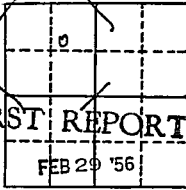TOPS	DEPTH	LOG	DATUM	Loc. in Sec.
Anh.				SW NE NW
Tr.				
H.				
Tr.				
Dg.				
Bl.				
L.				Geol. _____
K.C.				Contr. _____
B.K.C.				Hulme Drig.
Ce.				
C.				
M.				Pool
M.				Driftwood
K.				<div style="border: 1px solid black; padding: 5px; text-align: center;">  </div>
Mz.				
Ma.				
V.				
S.				
S.				
A.				
R.				
Pe.				
G.				
T.D.				

FIRST REPORT  
 FEB 29 '56

Date Comm. \_\_\_\_\_  
 Location \_\_\_\_\_

~~216~~

Co.  
 Sec.  
 T.  
 R.



MAR 7 1956

**R. G.**

County Barber Elev. 1562  
 Sec. 12 Twp. 34 Rge. 13W  
 Company Skelly Oil  
 Farm Name M. C. Donovan No. 1

TOPS	DEPTH	LOG	DATUM
Anh.			
Tr.			
H.	<u>3815</u>		<u>2253</u>
Tr.			
Dg.			
Bl.			
L.	<u>4010</u>		<u>2448</u>
K.C.			
B.K.C.	<u>4539</u>		<u>2977</u>
Ce. <u>Wanna</u>	<u>4552</u>		<u>2990</u>
C.			
M.	<u>4664</u>		<u>3102</u>
M.			
K.			
Mz.			
Ma.			
V.			
S.			
S.			
A.			
R.			
PE.			
G.			
T.D.	<u>4775</u>		

Loc. in Sec. SW NE NW

Geol. \_\_\_\_\_

Contr. \_\_\_\_\_

Hulme Drlg.

Pool \_\_\_\_\_

Driftwood

**COMPLETE**

Date Comm. 3-4-56 APR 11 1956

8 5/8" @ 272/225 DST 4668-4710

open 1 hr. gas in 3 min. 5,720 mcfg

rec. 70' drlg. mud 1643# DST 4700-40

open 55 min. gas in 2 min. 5,750 mcfg

rec. 3' gcm 1665# 5 1/2" @ 4775/150

GO to 4717 161/ 4704-32 1 mcfg

F/ 1,450 mcfg 500 A frac

F/ 4,450 mcfg PB 4692 141/ 4666-92

**OVER**

APR 19 1956

R. G.

F/362 mcfg 500 A frac F/4,350 mcfg  
Comp. open flow 45,247 mcfgpd