


DX 78-1 Meade

KANSAS

Section 12 Township 34 Range 26W

Well No. #1 Theis "A"

Company Graham-Michaelis

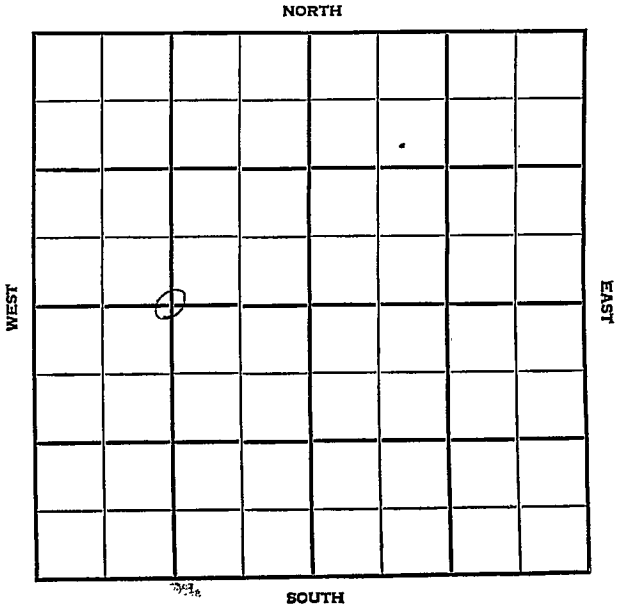

Meade

KANSAS

SEC. 12

TWP. 34

R. 26W

WELL NO. #1 Theis "A" FARM

COMPANY Graham - Michaelis

CONTRACTOR Co. Tools

McKinney


FT. FROM N. LINE

FT. FROM S. LINE

FT. FROM E. LINE

FT. FROM W. LINE

C W/2

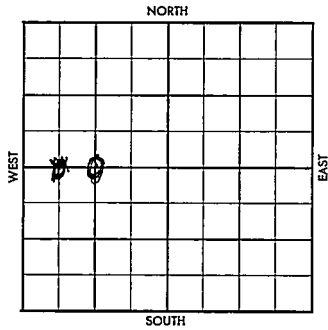

1956

ELEVATION

REPORT

7-11

RUR

COMPLETED

~~35~~

County **Meade** Elev. _____
 Sec. **12** Twp. **34** Rge. **26W**
 Company **Graham-Michaelis**
 FarmName **Theis "A"** No. **1**

Co.

TOPS	DEPTH	LOG	DATUM
Anh.			
Tp.			
H.			
Tr.			
Dg.			
Bl.			
L.			
K.C.			
B.K.C.			
Ce.			
C.			
M.			
M.			
K.			
Mz.			
Mo.			
V.			
S.			
S.			
A.			
R.			
Pe.			
G.			
T.D.			

Loc. in Sec. **C W/2**
 Geol. _____
 Contr. **Co. tools**
 Pool **McKinney**
 FIRST-REPORT
 JUL 11 '56

Lse.

No.

Sec.

T.

R.

Date Comm. **RUR**

2251 6 I 11

R.C.

 Company Graham-Michaolis
 Farm Name Thois UAH No. 1

TOPS	DEPTH	LOG	DATUM	Loc. in Sec.
Anh.				7 1/2
Tr.				
H.	4342	4342		
Tr.				
Dg.				
BL.				
L.		4532		Geol.
K.C. <u>Mudsh</u>		5653		Contr.
B.K.C. <u>" sd</u>		5678		
Ce.				
C. <u>chest</u>		5691		3. tools
M.				Pool
M.				clinary
K.				
Mz.				
Mo.				
V.				
S.				
S.				
A.				
R.				
PE.				
G.				
TD.	5830			COMPLETE

Date Comm. 7-10-56
RUR JUL 18 '56 Rng surf @ 1157
JUL 25 '56 878 1157/550 WOR
AUG 1 '56 MIR AUG 8 '56 ~~1157~~
AUG 15 '56 ~~1157~~ 4379 AUG 22 '56
~~1157~~ 5401 AUG 29 '56 5663 SEP 5 '56
DST 5650-72 45" 5' Md BHP
230/20" DST 5650-5700 45" 5'
Md BHP 50 1/2" DST 5724-80 45'
acc 15' Md 80/20 5 1/2 @ 5829 CO

40/5737-47 12/5767-70 11/2

N.S. Δ N.S. GAS SEP 1-50 11/0

9a 500 MCF PB 5725?

24/5680-84 24/5692-98

Frac CO? All 225. 9a.

5 MILL CFBpd W.O. PIPE
LINE COMPLETE