


SECTION 12 TOWNSHIP 34S RANGE 31WWELL NO. #1 GruberCOMPANY ## Texas Co. & Gilcrease 50%

NORTH

C NE/4

WEST

EAST

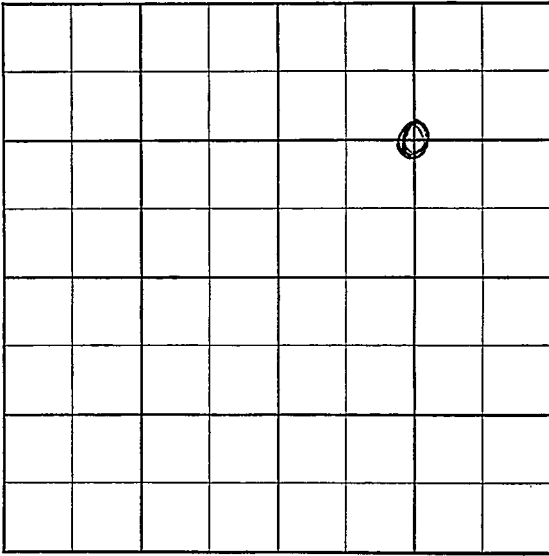

SOUTH

WILDCAT

S-513-A

CO. Seward ELEV. _____
 SEC. 12 TWP. 3N RGE. 31W
 COMPANY Texas Co. NO. 1

FIRST	SECOND	THIRD

FARM Gruber
 LOC. C NE/4

GEOLOGICAL _____
 CONTR. _____
 POOL Wildcat
 SPUD _____
Location

CO.
LSE.
NO.
SEC.
TWP.
RGE.

CO. Seward ELEV. 27130
 SEC. 12 TWP. 34 RGE. 31W ABANDONED
 COMPANY Texas Co. NO. 1
 GILBERT 5076

FEB 5 '58

FARM Gruber

LOC. C NE/4

GEOL.

CONTR.

POOL Wildcat

SPUD 12-12-57

Location

13" 597/600

2315

DEC 26 '57 8" 2690/300

DST 2827-43

35" 40' M FPO

BHP 600/45" 3698

JAN 4 '58 HB 4368 L4456

DST 4515-54 60"

35' M FPO BHP 1200/45

4900 JAN 6 '58 ATOKA 5603

DST 5680-5722 120"

218' H 900 5' M 40' FPO 75

-90 BHP 1890-550/45

Backs Tops best

DST Marm 5210 Ce 5396

DST 5495-5531 op 60"

810' gip 70' gcm FPO 37-57

BHP 581/45" Mors

5750 Mors 5792 DST

5773-5803 120" g 13"

TSTM rel 75' H gcm

FPO 20-35 BHP 1630/60"

DST 5811-35 60" 30' gip

75' VS gcm FPO 47-47 BHP

99/45" Chester 5865

5 1/2 6029 analog rods

HB 4352 TR 4392 Lsg 4516

Marm 5192 Ce 5386 ATOKA

5568 Mors 5713 Chester

5872 ST 6014 JAN 22 '58 CO

6025 28/ 6013-20 11 5 Ld

JAN 29 '58 BHP 5820 64/5792-5808

Free 9x5 ga 340 mef + Ld

Free 12x12 ga 900 mef + Ld

+ ST FEB 5 '58 CO 6025 ga

539 mef + Ld 240 mef

+ Ld thru tbg SIP 900

51

TbA

want test atoka