


Section 12 Township 34 Range 36W

Well No. 1 Bevans

Company Northern Nat. Gas

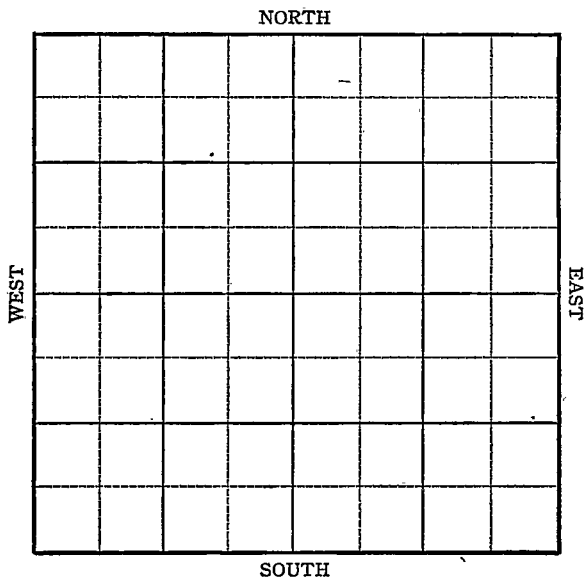

KANSAS

Sec. 12 Twp. 34 R. 36W

Well No. #1 Bevans Farm

Northern Nat. Gas Company


Hugoton'

 Ft. from N. Line

100 Ft. from S. Line

100 Ft. from E. Line

 Ft. from W. Line

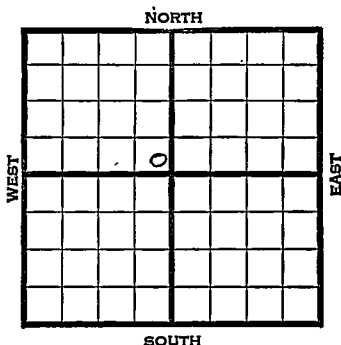

SE NW Elev. 3038

REPORT

1945

6/20 Drlg. 715'

6/28 10" @ 725
Drlg. 2214

7/3 7" @ 2649'

TD 2662' RUST

7/11 " " "

7/19 " " "

7/26 " " "

8/1 Drlg. 2675

8/8 TD 2820

185' of 5" liner @ 2820

8/15 12500 acid

6 M Gas

8/22 " "

8/29 " "

9/5 7" @ 2649

185' of 5" Perf. Liner @ 2820

12500 acid.

TD 2820'

24,829,000 Gas

430# R Pr.

COMPLETED

Kansas Pool Name HugotonMap No. _____ Sec. 12 Twp. 34 R. 36WWell No. 1 Bevans

_____ Northern Nat. gas _____ Company

CORRECTION

_____ Contractor

SE NW

SECTION PLAT

_____ Ft. from N. Line

100 Ft. from S. Line100 Ft. from E. Line

_____ Ft. from W. Line

| | | | |
|--|--|--|--|
| | | | |
| | | | |
| | | | |
| | | | |
| | | | |

Stevens County

Location _____

Rig up _____

Drilling and Remarks:
reported SW NW**RECORD**

Cased _____ in. _____ ft.

Sand _____

Gas _____

Oil _____

Total Depth _____

PRODUCTION

1st 24 hrs. Nat. _____

1st 24 hrs. after shot _____

Gas _____ Cu. Ft.

Dry Hole _____

Abandoned _____

Date

JUN 20 194519S. J. LEWISScout

KANSAS

Kansas

Pool Name Hugoton

Map No. 10 Sec. 12 Twp. 34 R. 36W

Well No. 1 Bevans

Northern Nat. Gas Company

COMPLETED

Contractor

E 1.3038

SE NW

SECTION PLAT

 Ft. from N. Line

100 Ft. from S. Line

100 Ft. from E. Line

1 Ft. from W. Line

| | | | |
|--|--|--|--|
| | | | |
| | | | |
| | | | |
| | | | |

Stevens County

Location _____

Rig up _____

Drilling and Remarks:

7" C2649
185' of 5" pay liner
C2820
12500 cu ft
24,929,000 Gas
*480 * R. P.*

RECORD

Cased in., ft.

Sand _____

Gas _____

Oil _____

Total Depth 2820

PRODUCTION

1st 24 hrs. Nat. _____

1st 24 hrs. after shot _____

Gas _____ Cu. Ft.

Dry Hole _____

Abandoned _____

Date

SEP 5 1945 19

S. J. LEWIS

Scout