


Section 12 Township 34 Range 43W

Well No. #1 Hurt

Company Panhandle Eastern

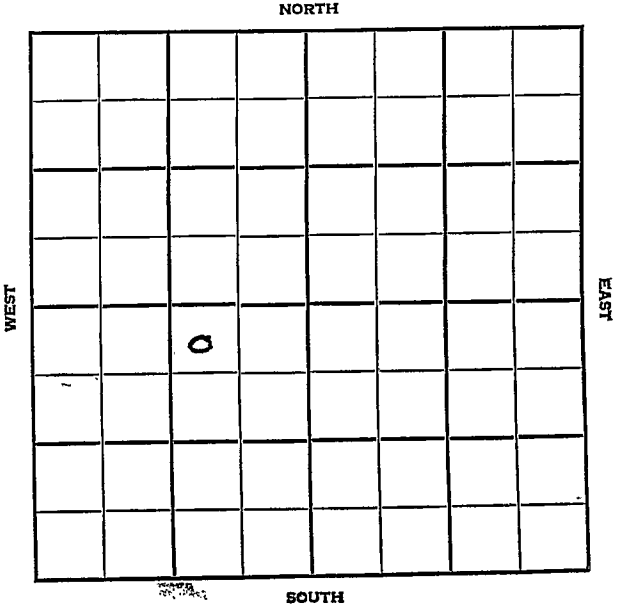

Morton KANSAS

SEC.	12	TWP.	34	R.	43W
------	----	------	----	----	-----

WELL NO. **1 Hurt** FARM

COMPANY **Panhandle Eastern**


CONTRACTOR **Moran Drlg.
Greenwood Pool**

_____ Ft. from N. Line

2440 _____ Ft. from S. Line

_____ Ft. from E. Line

1600 _____ Ft. from W. Line

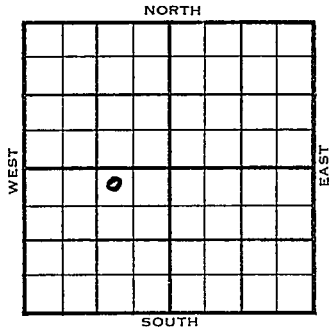

NW NE SW

	ELEVATION	REPORT
--	-----------	--------

1955

4/13

S pud 4-8-55
10" @ 612', WOC

