


Map No. KANSAS Sec. 12 Twp. 34 R. 38^w

Well No. 1 - ~~Greenwood~~ Farm

Texas Interstate Oil Company
and McKnabb

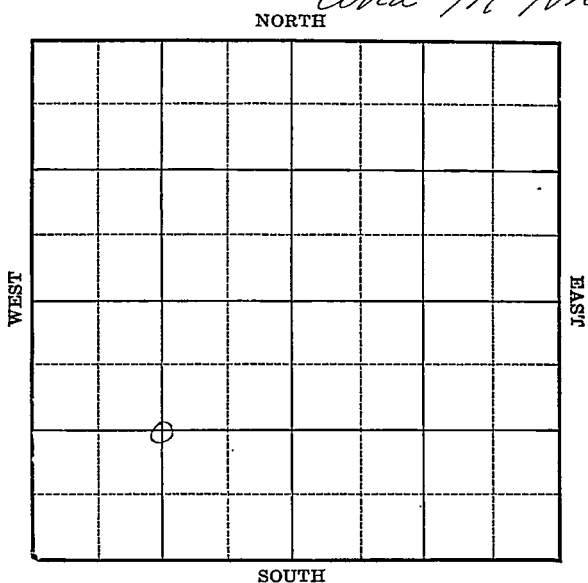

Location _____
Drilling Remarks _____

Rig Up _____
Drilling Remarks _____

RECORD

Cased _____ in. _____ ft.
Sand _____
Gas _____
Oil _____
Total Depth _____

PRODUCTION

1st 24 hrs. Nat. _____
1st 24 hrs. after shot _____
Gas _____ cu. ft. _____
Dry Hole _____
Abandoned _____

Map No. KANSAS Sec. 12 Twp. 34 R. 38w

Well No. 1-~~Stevens~~ Greenwood Farm

Texas Interstate Oil & Gas Company
McKnabb NORTH


_____ Ft. from N. Line

1320 Ft. from S. Line

_____ Ft. from E. Line

1320 Ft. from W. Line

1931

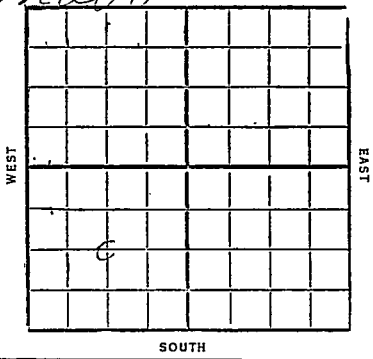

Date

REPORT

1/14
1/21
1/28
2/4
2/11
2/18
2/25
3/4
3/11
3/18
3/25
4/8
4/15
4/22
4/29

Loc

Prod.
Gas up
2.130'
" 2.130'
" 2.530'

T.D. 2800'
4 ft gas
Comp.


Map No. KANSAS Sec. 12 Twp. 34 R. 28W

Well No. 1 Stuart

Texas Interstate P. & M. Co. Company

Contractor

SECTION PLAT

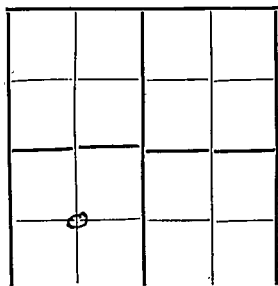

_____ Ft. from N. Line

1820 Ft. from S. Line

_____ Ft. from E. Line

1820 Ft. from W. Line

FIRST REPORTS

Location ✓

Rig up _____

Drilling and Remarks:

RECORD

Cased _____ in., _____ ft.

Sand _____

Gas _____

Oil _____

Total Depth _____

PRODUCTION

1st 24 hrs. Nat. _____

1st 24 hrs. after shot _____

Gas _____ Cu. Ft.

Dry Hole _____

Abandoned _____

Date

JAN 14 1931

S. J. LEWIS Scout


*no small
no more*

Returned	
Cards	<i>2</i>
Tracing	<i>X</i>
France Map	<i>X</i>
Scarborough Map	<i>X</i>
Moody Map	<i>X</i>
Scarborough Port Hook	
Moody Port Hook	<i>OK</i>

Map No. KANSAS Sec. 12 Twp. 34 R. 38WWell No. 1 GreenwoodTexas Interstate Oil & Gas Co. Company

Contractor

SECTION PLAT

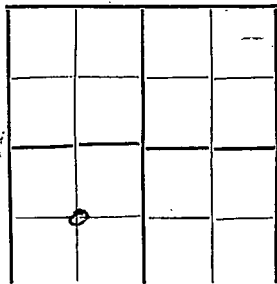

Ft. from N. Line

1220 Ft. from S. Line

Ft. from E. Line

1240 Ft. from W. Line

CORRECTION

Location

Rig up

Drilling and Remarks:

RECORD

Cased.....in.,ft.

Sand.....

Gas.....

Oil.....

Total Depth.....

PRODUCTION

1st 24 hrs. Nat.....

1st 24 hrs. after shot.....

Gas.....Cu. Ft.

Dry Hole.....

Abandoned.....

Date

MAR 25 1931

192

S. J. LEWIS Scout

no small map
no wood

Returned	
Cards	
Tracing	X
France Map	X
Scarborough Map	X
Moody Map	X
Scarborough Plat Book	
Moody Plat Book	

Stevens

Map No. **KANSAS** Sec. **12** Twp. **34** R. **38 W**Well No. **1 Greenwood****Texas Interstate Ph** Company


Contractor

COMPLETE**SECTION PLAT**

Ft. from N. Line

1320 Ft. from S. Line

Ft. from E. Line

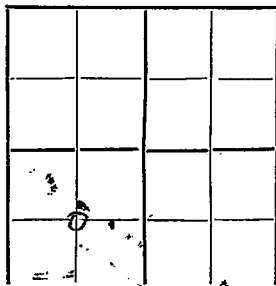1320 Ft. from W. Line

Location

Rig up

Drilling and Remarks:

RECORD

Cased _____ in., _____ ft.

Sand _____

Gas _____

Oil _____

Total Depth **2800****PRODUCTION**

1st 24 hrs. Nat. _____

1st 24 hrs. after shot _____

Gas **H 44** Cu. Ft.

Dry Hole _____

Abandoned _____

Date

APR 29 1931**CHAS. L. SHERWOOD**

192

Scout

no small note
no more

Returned	
Cards	<i>[Signature]</i>
Tracing	<i>[X]</i>
France Map	<i>[X]</i>
Scarborough Map	<i>[X]</i>
Moody Map	<i>[X]</i>
Scarborough Plat Book	
Moody Plat Book	