6-34-13W

CONFIDENTIAL

SIDE ONE

STATE CORPORATION COMMISSION OF KANSAS
OIL & GAS CONSERVATION DIVISION
WELL COMPLETION OR RECOMPLETION FORM
ACO-1 WELL HISTORY
DESCRIPTION OF WELL AND LEASE

API NO. 15-007-22,234

County Barber

W/2 NW NW Sec. 6 Twp. 34 Rge. 13 __ East X West

4620 Ft North from Southeast Corner of Section
4950 Ft West from Southeast Corner of Section
(Note: Locate well in section plat below)

Lease Name Kincaid Well # 1-6

Field Name Aetna

Producing Formation Mississippi

Elevation: Ground 1795' KB 1800'

Section Plat

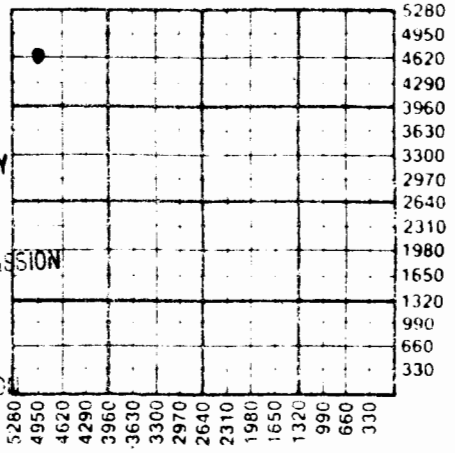


Operator: License # 03532
Name CMX, Inc.
Address 1026 Union Center Bldg.
City/State/Zip Wichita, KS 67202

Purchaser Unknown

Operator Contact Person Doug McGinness II
Phone (316) 269-9052

Contractor: License # 5864
Name Lobo Drilling Co.

Wellsite Geologist Doug McGinness II
Phone (316) 269-9052

RECEIVED
STATE CORPORATION COMMISSION
JUN -2 1989
CONSERVATION DIVISION
Wichita, Kansas

JUN 13 1989
KANSAS GEOLOGICAL SURVEY
WICHITA BRANCH

Designate Type of Completion
X New Well __ Re-Entry __ Workover

X Oil __ SWD __ Temp Abd
X Gas __ Inj __ Delayed Comp.
__ Dry __ Other (Core, Water Supply etc.)

If OWWO: old well info as follows:
Operator
Well Name
Comp. Date Old Total Depth

WELL HISTORY

Drilling Method:
X Mud Rotary __ Air Rotary __ Cable

| 4-12-89 | 4-19-89 | 5-8-89 |
|---|---|---|
| Spud Date | Date Reached TD | Completion Date |

| 4900' | 4871' |
|---|---|
| Total Depth | PBTD |

Amount of Surface Pipe Set and Cemented at 423 feet
Multiple Stage Cementing Collar Used? __ Yes X No
If yes, show depth set feet
If alternate 2 completion, cement circulated
from feet depth to w/ SX cmt
Cement Company Name
Invoice #

WATER SUPPLY INFORMATION

Disposition of Produced Water: __ Disposal
Docket # __ Repressuring

Questions on this portion of the ACO-1 call:
Water Resources Board (913) 296-3717

Source of Water:
Division of Water Resources Permit #

__ Groundwater Ft North from Southeast Corner
(Well) Ft West from Southeast Corner of
Sec Twp Rge __ East __ West

X Surface Water approx 4620 Ft North from Southeast Corner
(Stream, pond etc) 4950 Ft West from Southeast Corner
Sec 6 Twp 34 Rge 13 __ East X West

__ Other (explain)
(purchased from city, R.W.D. #)

INSTRUCTIONS: This form shall be completed in triplicate and filed with the Kansas Corporation Commission, 200 Colorado Derby Building, Wichita, Kansas 67202, within 120 days of the spud date of any well. Rule 82-3-130, 82-3-107 and 82-3-106 apply.
Information on side two of this form will be held confidential for a period of 12 months if requested in writing and submitted with the form. See rule 82-3-107 for confidentiality in excess of 12 months.
One copy of all wireline logs and drillers time log shall be attached with this form. Submit CP-4 form with all plugged wells. Submit CP-111 form with all temporarily abandoned wells.