

STATE CORPORATION COMMISSION OF KANSAS
OIL & GAS CONSERVATION DIVISION

WELL COMPLETION OR RECOMPLETION FORM
ACO-1 WELL HISTORY

DESCRIPTION OF WELL AND LEASE

Operator: license # 6006
name Molz Oil Company
address R.R. #2, Box 54
City/State/Zip Kiowa, Kansas 67070

Operator Contact Person Jim Molz
Phone (316) 296-4558

Contractor: license # 5856
name Sweetman Drilling, Inc.

Wellsite Geologist Gordon W. Keen
Phone (405) 947-1238

PURCHASER

Designate Type of Completion

- ☐ New Well ☐ Re-Entry ☐ Workover
- ☐ Oil ☐ SWD ☐ Temp Abd
☐ Gas ☐ Inj ☐ Delayed Comp.
☒ Dry ☐ Other (Core, Water Supply etc.)

If OWWO: old well info as follows:

Operator
Well Name
Comp. Date Old Total Depth

WELL HISTORY

Drilling Method: ☒ Mud Rotary ☐ Air Rotary ☐ Cable

6/21/84 7/1/84 7/2/84
Date Date Reached TD Completion Date

5250'
Total Depth PBTD

Point of Surface Pipe Set and Cemented at 267' feet

Multiple Stage Cementing Collar Used? ☐ Yes ☒ No

If Yes, Show Depth Set feet

If alternate 2 completion, cement circulated

from feet depth to w/ SX cmt

API NO. 15-007-21,846 11-34-13W

County Barber

Sec 11 Twp 34S Rge 13 West
(location)

4,190... Ft North from Southeast Corner of Section
1,760... Ft West from Southeast Corner of Section
(Note: locate well in section plat below)


Lease Name Donovan E Well# 1

Field Name

Producing Formation

Elevation: Ground 1651 KB 1661

Section Plat

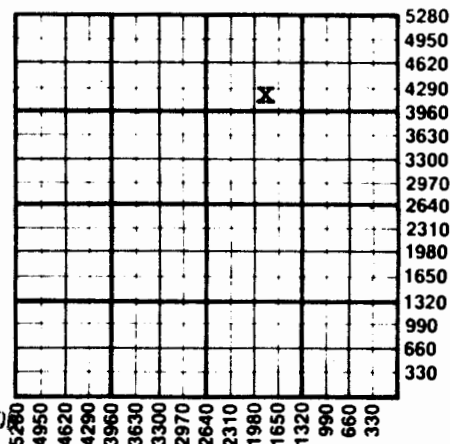

WATER SUPPLY INFORMATION

Division of Water:

Division of Water Resources Permit #

☐ Groundwater... Ft North From Southeast Corner and
(Well) ... Ft. West From Southeast Corner of
Sec Twp Rge ☐ East ☐ West

☐ Surface Water... Ft North From Southeast Corner and
(Stream, Pond etc.)... Ft West From Southeast Corner
Sec Twp Rge ☐ East ☐ West

☐ Other (explain)
(purchased from city, R.W.D.#)

Disposition of Produced Water: ☐ Disposal
☐ Repressuring

Docket #

INSTRUCTIONS: This form shall be completed in duplicate and filed with the Kansas Corporation Commission, 200 Colorado Derby Building, Wichita, Kansas 67202, within 90 days after completion or recompletion of any well. Rules 82-3-130 and 82-3-107 apply.

Information on side two of this form will be held confidential for a period of 12 months if requested in writing and submitted with the form. See rule 82-3-107 for confidentiality in excess of 12 months.

One copy of all wireline logs and drillers time log shall be attached with this form. Submit CP-4 form with all plugged wells. Submit CP-111 form with all temporarily abandoned wells.

Operator Name Molz Oil Company Lease Name Donovan E Well# 1 SEC 11 TWP 34s RGE 13 ☐ East ☒ West

INSTRUCTIONS: Show important tops and base of formations penetrated. Detail all cores. Report all drill stem tests giving interval tested, time tool open and closed, flowing and shut-in pressures, whether shut-in pressure reached static level, hydrostatic pressures, bottom hole temperature, fluid recovery, and flow rates if gas to surface during test. Attach extra sheet if more space is needed. Attach copy of log.

Formation	Description
XXLog	☐ Sample

Name	Top	Bottom
Permain	0	1,390
	1390	2,095
	2,095	2,920
Onaga	2,920	2,976
Waobaunsee	2,976	3,006
Elgin Zone	3,706	3,904
Heebner Shale	3,940	3,946
Douglas	3,946	4,108
Kansas City	4,108	4,759
Mississippi	4,759	4,900
Kinderhook Lime	4,900	4,956
Kinderhook Shale	4,956	5,017
Chattanooga	5,017	5,072
Viola	5,072	5,179
Simpson Shale	5,179	5,198
Simpson Sand	5,198	5,220
	5,220	5,250

TD 5250

DST #3 (Strad.-Hook Wall) 4526-
4549'
Rec. 90' Watery mud, 240' salt wt.
IF 68-137#/30"
FCIP 1704#/45"
FF 167-187#/60"
FCIP 1704#/90"
IH 2431#-2431# 120° F

DST #2 4587-4605 Rec. 260' sl muddy sal water
IFP 105-105#/30"
ICIP 1085#/45"
FFP 130-160#/60"
FCIP 1075#/90"
IH 2375# - FH 2375# 123°F

CASING RECORD ☒ new ☐ used Report all strings set - conductor, surface, intermediate, production, etc.							
Purpose of string	size hole drilled	size casing set (in O.D.)	weight lbs/ft.	setting depth	type of cement	# sacks used	type and percent additives
Surface.....	...15".....	10. 3/4"...		..267'.....	Common ..	...225....	
.....							
.....							
.....							

PERFORATION RECORD		Acid, Fracture, Shot, Cement Squeeze Record	
shots per foot	specify footage of each interval perforated	(amount and kind of material used)	Depth
.....			
.....			
.....			
.....			
.....			

11-34-13W⁸

WELL LOG
Donovan E #1
1090' FNL 880 FWL NE 11-34S-13W
Barber County, Ks.

Name of Operator: Molz Oil Co.
Route 2
Kiowa, Kansas 67070


Date Completed: July 2, 1984

FROM	TO	
0	365	Red Bed
365	1480	Red Bed and Shale
1480	4958	Lime and shale
4958	5250	Lime
5250		Total Depth

STATE OF KANSAS

COUNTY OF BARTON ss

Gary L. Hawk, Secretary of Sweetman Drilling, Inc. being first duly sworn on oath says: That I have knowledge of the facts, statements and matters herein contained and the log of the above described well as filed and that the same are true and correct.

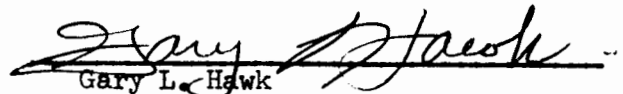
Gary L. Hawk

Subscribed and sworn before me this 11th day of July, 1984.


Notary Public Barton County

My Commission Expires:

February 7, 1988