


Section 13 Township 34 Range 12-W

Well No. #1 Humphrey

Company Flynn Oil

Wildcat

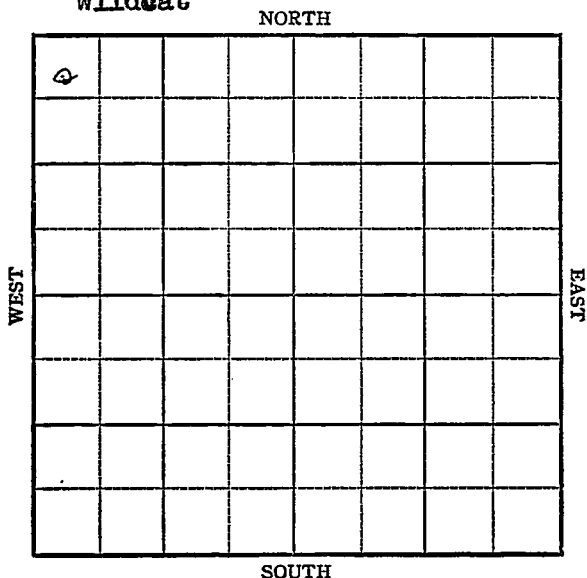

Sec. 13 Twp. 34 R. 12WWell No. #1 Humphrey Farm

Flynn Oil

Company

Wildcat


330' Ft. from N. Line

Ft. from S. Line

Ft. from E. Line

330' Ft. from W. Line

NW/C

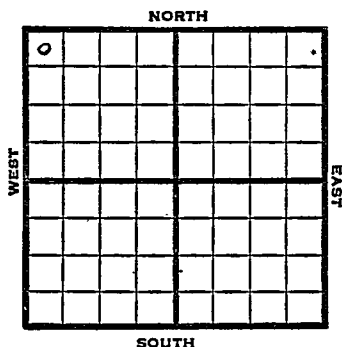

1948 Elev. 1446' REPORT

12/1 Location

12/6 "

12/14 "

12/22 Surface Hole

12/29 10" @ 415
Drlg. 2250'1/5 Elgin 3514'
Lansing 3917'
Drlg. 4100'

1/12 Drlg 5632

1/19 Miss 4627' Misener 4998'
Viola 5016' Simpson 5106'
Drlg. 5130'1/26 Arb. 5300'
TD 5340'

ABANDONED

Map No. 61 Sec. 13 Twp. 34 R. 12W

Well No. 1 Humphrey

Flynn Oil Company

ABANDONED Contractor

NW/C


E 1/4 46
SECTION PLAT

330 Ft. from N. Line

 Ft. from S. Line

 Ft. from E. Line

330 Ft. from W. Line

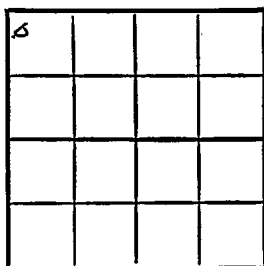

Barber County

Location

Rig up

Drilling and Remarks:

See 5300

RECORD

Cased in., ft.

Sand

Gas

Oil

Total Depth 5341

PRODUCTION

1st 24 hrs. Nat.

1st 24 hrs. after shot

Gas Cu. Ft.

Dry Hole

Abandoned

Date

JAN 26 1949 19

S. I. LEWIS Scout

Scout Cards
Land Small Map
Land Wall Map
Tracings
France Map
Pierce Map
Misc.

Map No. _____ Sec. 13 Twp. 34 R. 12W

Well No. 1 Humphrev

Flynn Oil Company

FIRST REPORT

Contractor

NW/C

SECTION PLAT

330 Ft. from N. Line

_____ Ft. from S. Line

_____ Ft. from E. Line

330 Ft. from W. Line

o			

Barber County

Location X

Rig up _____

Drilling and Remarks: _____

RECORD

Cased _____ in., _____ ft.

Sand _____

Gas _____

Oil _____

Total Depth _____

PRODUCTION

1st 24 hrs. Nat. _____

1st 24 hrs. after shot _____

Gas _____ Cu. Ft.

Dry Hole _____

Abandoned _____

Date

DEC 1 1948 19 S. J. LEWIS Scout

Scout Cards	
Land Small Map	
Land Wall Map	
Tracings	
Trance Map	
Pierce Map	
Misc.	